

STATE ENGINEER  
Salem, Oregon

KLAM 12556

# Well Record

STATE WELL NO. 39/9-7K(1)  
COUNTY Klamath  
APPLICATION NO.

OWNER: Suburban Water Company


MAILING  
ADDRESS:

LOCATION OF WELL: Owner's No. #1

CITY AND  
STATE:

NW 1/4 SE 1/4 Sec. 7 T. 39 N. S. R. 9 E. W.M.

Bearing and distance from section or subdivision  
corner

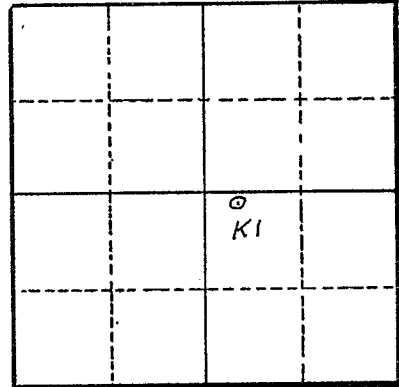

Section 7

Altitude at well 4250'

TYPE OF WELL: Drilled Date Constructed unknown

Depth drilled 400 Depth cased unknown

### CASING RECORD:

10 inch bore

### FINISH:

unknown

### AQUIFERS:

Basalt ?

### WATER LEVEL:

unknown

PUMPING EQUIPMENT: Type Turbine H.P.  
Capacity 150 G.P.M.

### WELL TESTS:

Drawdown ..... ft. after ..... hours ..... G.P.M.  
Drawdown ..... ft. after ..... hours ..... G.P.M.

USE OF WATER Municipal 225 customers Temp. °F., 19

SOURCE OF INFORMATION USGS Report Klamath River Basin

DRILLER or DIGGER

### ADDITIONAL DATA:

Log ..... Water Level Measurements ..... Chemical Analysis ..... Aquifer Test

### REMARKS:

Owners well No. 1 system supplies approximately 225 customers