

STATE ENGINEER
Salem, Oregon

Well Record

STATE WELL NO. 39/9-7K2
COUNTY Klamath
APPLICATION NO. _____

KLAM 12557


OWNER: Suburban Water Company

MAILING ADDRESS:
CITY AND STATE:

LOCATION OF WELL: Owner's No. #2

NW 1/4 SE 1/4 Sec. 7 T. 39 S., R. 9 W., W.M.

Bearing and distance from section or subdivision corner

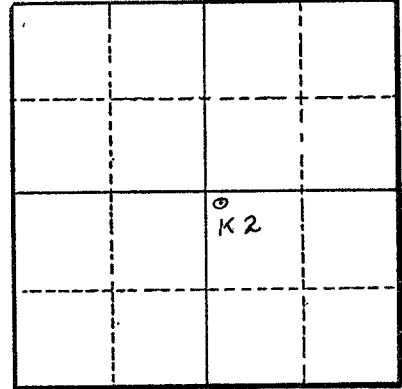

Section 7

Altitude at well 4250'

TYPE OF WELL: Drilled Date Constructed

Depth drilled 400 Depth cased

CASING RECORD:
10-inch unknown

FINISH:

unknown

AQUIFERS:

Basalt

WATER LEVEL:

unknown

PUMPING EQUIPMENT: Type Turbine H.P.
Capacity 50 G.P.M.

WELL TESTS:

Drawdown ft. after hours G.P.M.
Drawdown ft. after hours G.P.M.

USE OF WATER Municipal Temp. °F., 19

SOURCE OF INFORMATION U.S.G.S. Report - Klamath River Basin

DRILLER or DIGGER

ADDITIONAL DATA:

Log Water Level Measurements Chemical Analysis Aquifer Test

REMARKS:

75 feet west from Well #1