

STATE ENGINEER
Salem, Oregon *KLAM 12636*

Well Record

STATE WELL NO. *39/9-16EL*
COUNTY *Klamath*
APPLICATION NO.

OWNER: *T. P. Packing Co.*


MAILING ADDRESS:

LOCATION OF WELL: Owner's No.

CITY AND STATE:

1/4 *1/4* Sec. T. N. E.
S., R. W., W.M.

Bearing and distance from section or subdivision corner

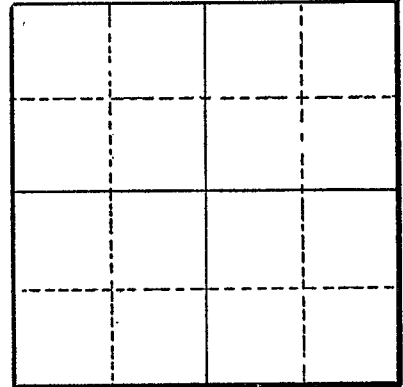

Section

Altitude at well *4,095*

TYPE OF WELL: *Drilled* Date Constructed

Depth drilled *618* Depth cased *39*

CASING RECORD:

8 inch

FINISH:

AQUIFERS: *"Clay" from 35 to 185*
Basalt from 611 to 618

WATER LEVEL:
8 feet below land surface on October 10, 1954

PUMPING EQUIPMENT: Type H.P.
Capacity G.P.M.

WELL TESTS:
Drawdown ft. after hours G.P.M.
Drawdown ft. after hours G.P.M.

USE OF WATER *Industrial* Temp. °F., 19.....

SOURCE OF INFORMATION *USGS*

DRILLER or DIGGER

ADDITIONAL DATA:
Log *X* Water Level Measurements Chemical Analysis Aquifer Test

REMARKS:

Water level draws down 32 ft. when well is bailed at 30 ft.

