

STATE ENGINEER
Salem, Oregon

KLAM
12651

Well Record


STATE WELL NO. 39/9-18M(1)
COUNTY Klamath
APPLICATION NO.

OWNER: Weyerhaeuser Timber Co. MAILING ADDRESS: P. O. Box 651

LOCATION OF WELL: Owner's No. #3 CITY AND STATE: Klamath Falls, Oregon

NW 1/4 SW 1/4 Sec. 18 T. 39 N. S. R. 9 E. W.M.

Bearing and distance from section or subdivision corner 505' S & 460' E of W 1/4 cor. Sec. 18

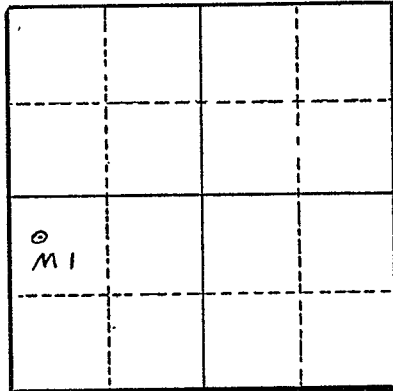

Section 18

Altitude at well 4175' Interpolated

TYPE OF WELL: Drilled Date Constructed 10/18/45

Depth drilled 177' Depth cased 177'

CASING RECORD:

10 inch steel casing from 0 to 177 feet

FINISH:

Perforated from 89 to 123 feet and from 144 to 177 feet

AQUIFERS:

Sand and gravel 18 to 116 feet "Gravel" from 89 to 133
Lava rock from 116 to 177 feet Basalt from 154 to 177

WATER LEVEL:

89.9 feet below land surface on 10/26/54

PUMPING EQUIPMENT: Type Pomona Turbine 4" H.P. 15
Capacity 200 G.P.M.

WELL TESTS:

Drawdown 5 1/2 ft. after 18 hours pumping 170 10/27/54 G.P.M.
Drawdown ft. after hours G.P.M.

USE OF WATER Industrial 20% Dom. 80% Temp. °F., 19

SOURCE OF INFORMATION Registration Statement Not valid - East of Cascades

DRILLER or DIGGER

ADDITIONAL DATA:

Log Water Level Measurements Chemical Analysis Aquifer Test

REMARKS:

Hardness 33 ppm
Chloride 5 ppm

