

KLAM 12652

ORIGINAL File Original and Duplicate with the STATE ENGINEER, SALEM, OREGON

RECEIVED NOV 29 1956

WATER WELL REPORT KLAM STATE OF OREGON 12652

State Well No. 349-1FM2 State Permit No. G 342

(1) OWNER:

Name Weyerhaeuser Timber Company Address Klamath Falls, Oregon

(2) LOCATION OF WELL:

County Klamath Owner's number, if any- No. 4 NW 1/4 SW 1/4 Section 18 T. 39 S R. 9E W.M. Bearing and distance from section or subdivision corner 400 feet South and 500 feet East from West 1/4 corner of Section 18

(3) TYPE OF WORK (check):

New Well [X] Deepening [] Reconditioning [] Abandon [] If abandonment, describe material and procedure in Item 11.

(4) PROPOSED USE (check):

Domestic [X] Industrial [X] Municipal [] Irrigation [] Test Well [] Other []

(5) TYPE OF WELL:

Rotary [] Driven [] Cable [X] Jetted [] Dug [] Bored []

(6) CASING INSTALLED:

Threaded [] Welded []

See Rob- son & Roberts drawing No A-186 Diam. from ft. to ft. Gage

(7) PERFORATIONS:

Perforated? [] Yes [X] No

Table with columns: Type of perforator used, SIZE of perforations, in. by, in., ft. to ft.

(8) SCREENS:

Well screen installed [] Yes [X] No

Manufacturer's Name Type Model No. Diam. Slot size Set from ft. to ft.

(9) CONSTRUCTION:

Is well gravel packed? [] Yes [X] No Size of gravel: Gravel placed from ft. to ft. Was a surface seal provided? [X] Yes [] No To what depth? See R & R Drawing A-186 Material used in seal- Did any strata contain unusable water? [] Yes [X] No Type of water? Depth of strata Method of sealing strata off

(10) WATER LEVELS: See R & R Drawing A-185

Static level ft. below land surface Date Artesian pressure lbs. per square inch Date

Log Accepted by:

[Signed] Date 11-28-1956 (Owner)

Mechanical Superintendent

(11) WELL TESTS:

Drawdown is amount water level is lowered below static level

Was a pump test made? [X] Yes [] No If yes, by whom? See Drwg. A-185

Table with columns: Yield, gal./min. with, ft. drawdown after, hrs. Bailer test, Artesian flow, Temperature of water, Was a chemical analysis made?

(12) WELL LOG:

Diameter of well inches.

Depth drilled ft. Depth of completed well ft.

Formation: Describe by color, character, size of material and structure, and show thickness of aquifers and the kind and nature of the material in each stratum penetrated, with at least one entry for each change of formation.

Table with columns: MATERIAL, FROM, TO. Contains text: See R & R Drawing No. A-186

Work started 19 Completed 19

(13) PUMP:

Manufacturer's Name Type: H.P.

Well Driller's Statement:

This well was drilled under my jurisdiction and this report is true to the best of my knowledge and belief.


W.L. Hartley and Son NAME (Person, firm, or corporation) (Type or print) Address Box 146 Bonanza, Oregon

Driller's well number

[Signed] W.L. Hartley Robert F. Hartley (Well Driller)

License No. 164 Date Nov 28, 1956

LOG & CONSTRUCTION, WELL No. 4

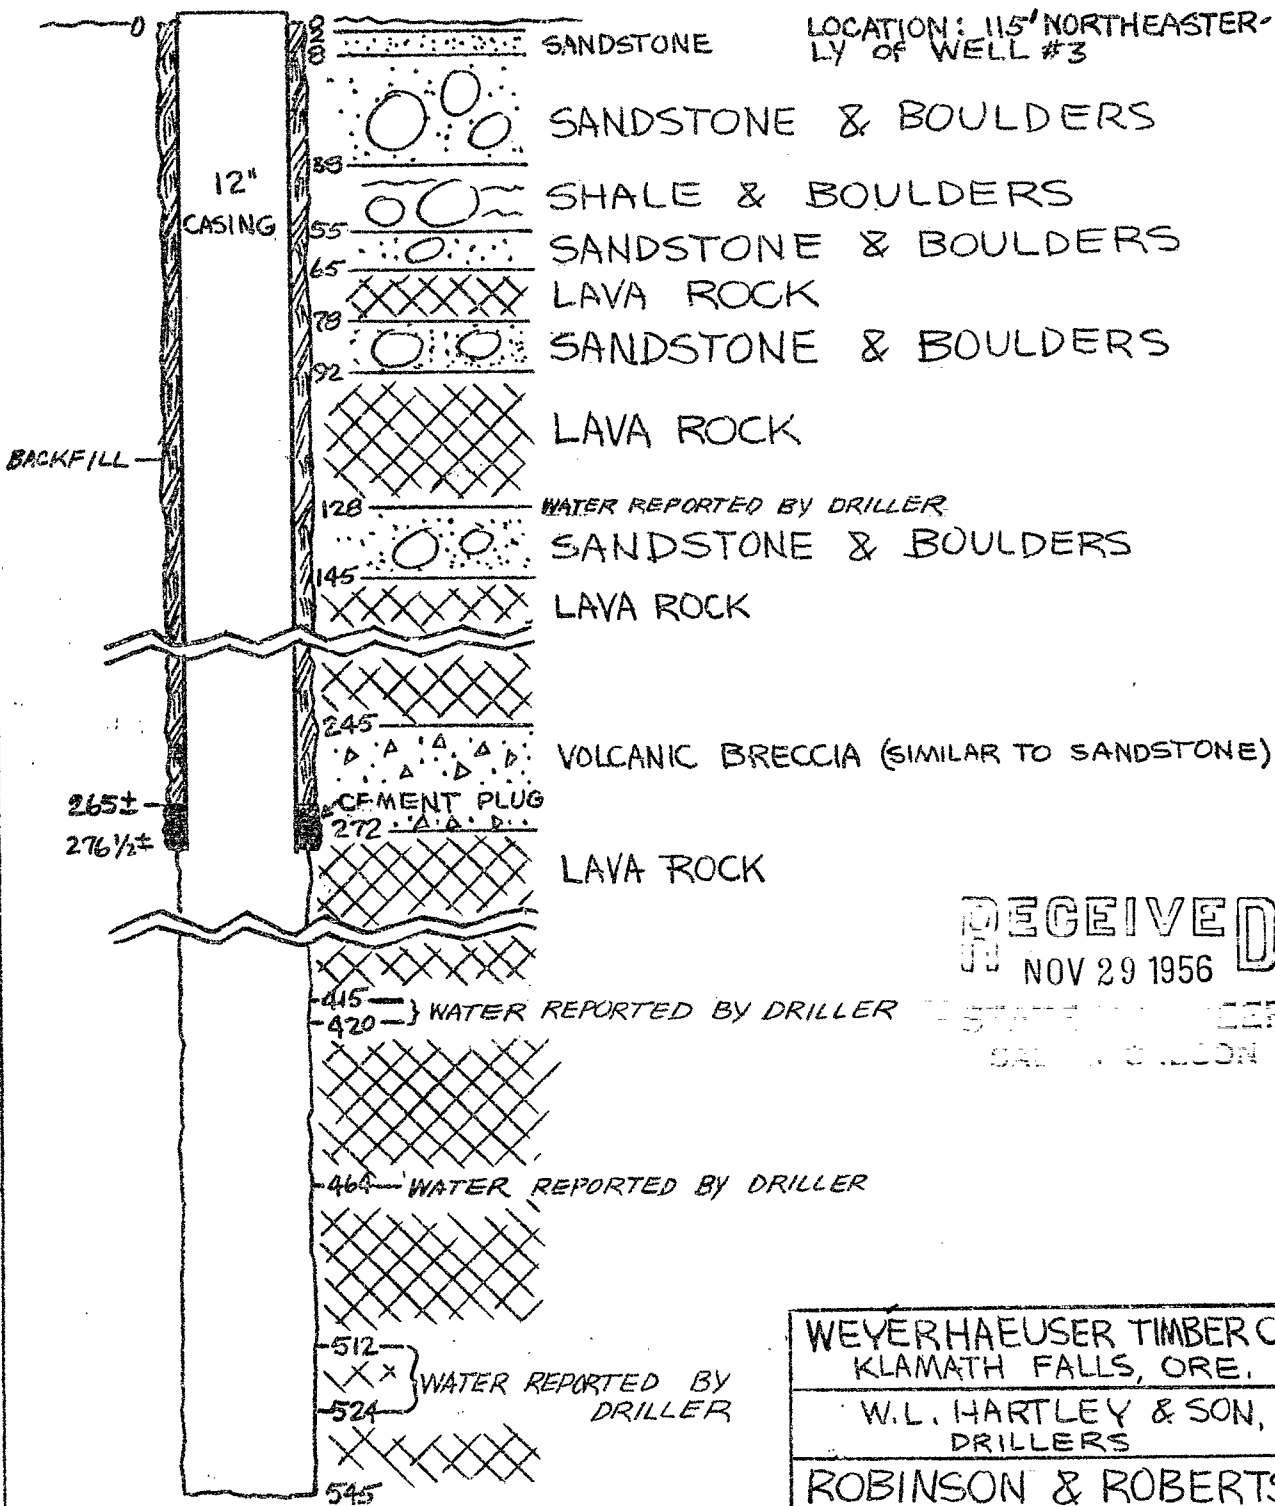

RECEIVED
NOV 29 1956

STATE ENGINEER
SALMON DIVISION

WEYERHAEUSER TIMBER CO.
KLAMATH FALLS, ORE.


W.L. HARTLEY & SON,
DRILLERS

ROBINSON & ROBERTS
GROUNDWATER GEOLOGISTS
TACOMA, WASH.

Fred B Roberts

10-26-56 | PHR | A-186

WELL No. 4
DRAWDOWN TEST - OCT. 16, 1956

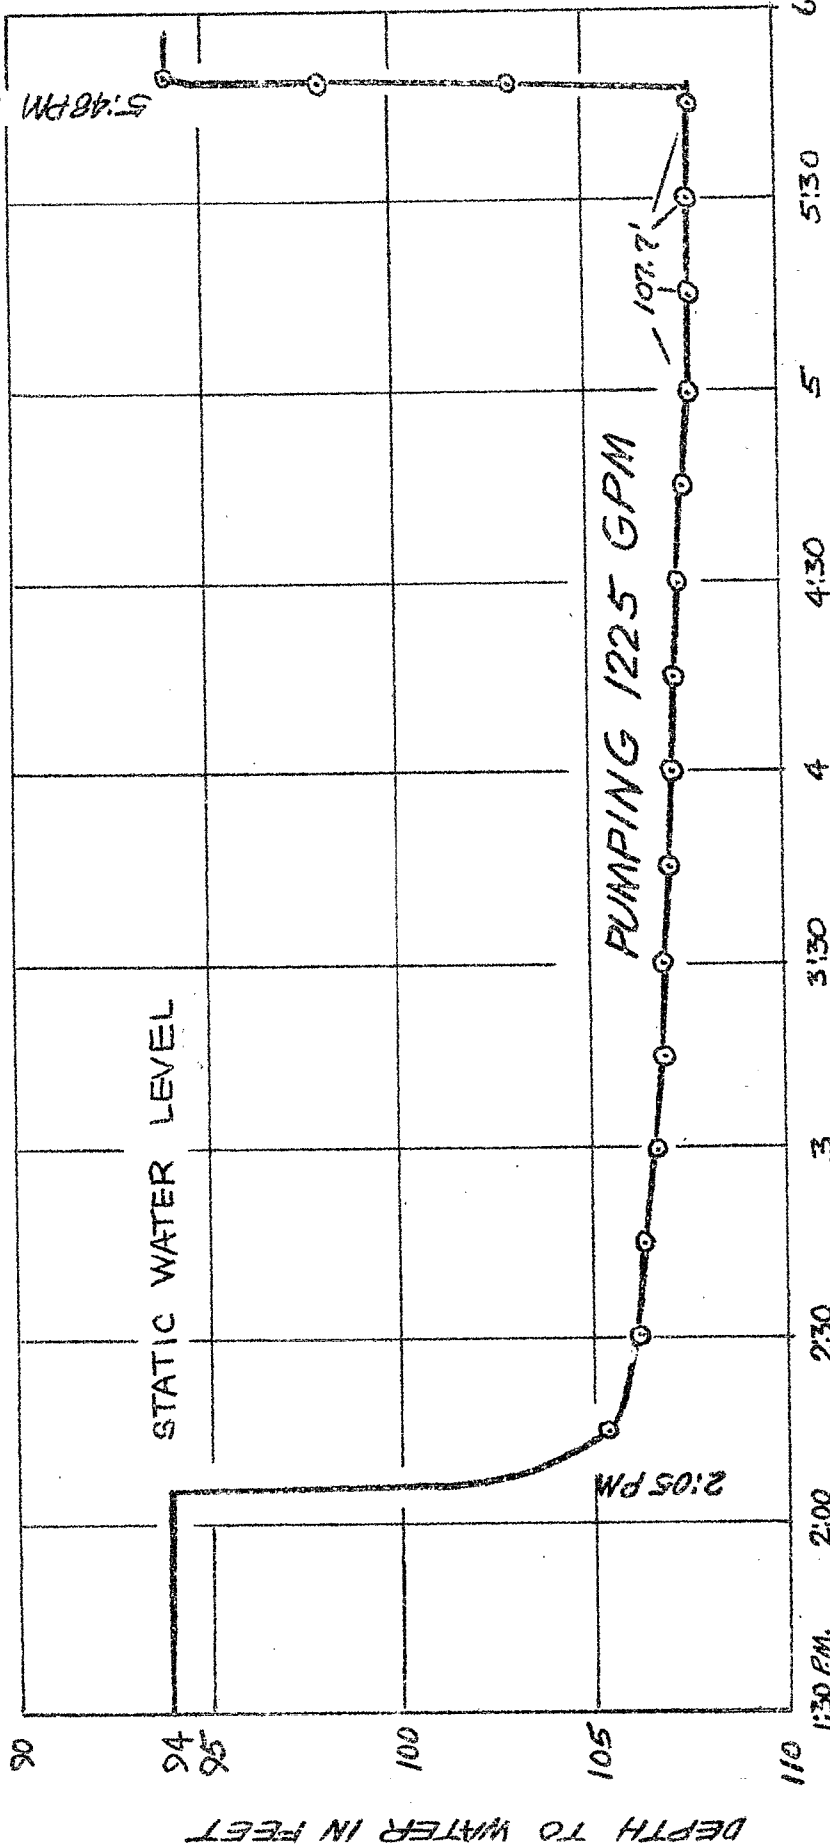

WEYERHAEUSER TIMBER CO. - Klamath Falls
 DRILLERS - W.L. HARTLEY & SON
 ROBINSON & ROBERTS
 GROUNDWATER GEOLOGISTS - TACOMA WASH.
Fred B. Roberts
 10-24-56 | P H R | A-185

RECEIVED
 NOV 29 1956
 STATE ENGINEER
 OREGON

PUMP ON

