

STATE ENGINEER  
Salem, Oregon

KLAM  
12860

# Well Record


STATE WELL NO. 39/10-6P(1)  
COUNTY Klamath  
APPLICATION NO. U-329

OWNER: George M. Wheeler  
MAILING ADDRESS: Route 2, Box 471

LOCATION OF WELL: Owner's No. \_\_\_\_\_  
CITY AND STATE: Klamath Falls, Oregon

SE 1/4 SW 1/4 Sec. 6 T. 39 N. S, R. 10 E, W.M.

Bearing and distance from section or subdivision  
corner N 66° 27' E 2025' from SW cor. Sec. 6

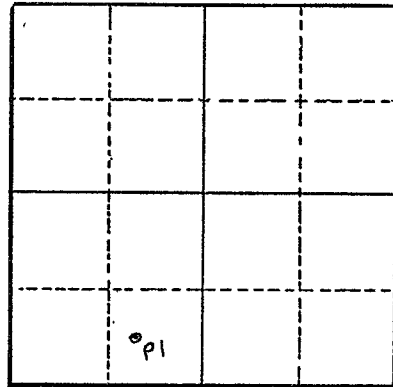

Section 6

Altitude at well \_\_\_\_\_

TYPE OF WELL: Drilled Date Constructed \_\_\_\_\_

Depth drilled 333 Depth cased \_\_\_\_\_

### CASING RECORD:

8 inch

### FINISH:

### AQUIFERS:

### WATER LEVEL:

150' below land surface

PUMPING EQUIPMENT: Type Turbine H.P. 20  
Capacity \_\_\_\_\_ G.P.M.

### WELL TESTS:

Drawdown 3 ft. after \_\_\_\_\_ hours 200 G.P.M.

Drawdown \_\_\_\_\_ ft. after \_\_\_\_\_ hours \_\_\_\_\_ G.P.M.

USE OF WATER Irrigation Temp. 63 °F. March 25, 19 49

SOURCE OF INFORMATION U-329

DRILLER or DIGGER \_\_\_\_\_

### ADDITIONAL DATA:

Log \_\_\_\_\_ Water Level Measurements \_\_\_\_\_ Chemical Analysis \_\_\_\_\_ Aquifer Test \_\_\_\_\_

### REMARKS: