

STATE ENGINEER  
Salem, Oregon

KLAM  
12893

OBSERVATION WELL  
Well Record

STATE WELL NO. 39/10-8J(1)  
COUNTY Klamath  
APPLICATION NO. U-487

OWNER: Mt. Calvary Cemetery Ass'n MAILING ADDRESS: 815 High Street

LOCATION OF WELL: Owner's No. 2 CITY AND STATE: Klamath Falls, Oregon

NE 1/4 SE 1/4 Sec. 8 T. 39 S., R. 10 W., W.M.


Bearing and distance from section or subdivision

corner S 41° 40' W 723

Altitude at well 4200

TYPE OF WELL: Drilled Date Constructed

Depth drilled 285 Depth cased

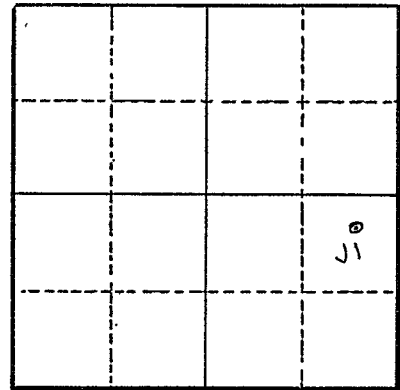

Section 8

CASING RECORD:

8 inch

FINISH:

AQUIFERS:

WATER LEVEL:

40 feet below land surface

PUMPING EQUIPMENT: Type Turbine H.P. 15  
Capacity 75 G.P.M.

WELL TESTS:

Drawdown 100 ft. after 2 hours pumping 90 G.P.M.

Drawdown ft. after hours G.P.M.

USE OF WATER Irrigation Temp. °F., 19

SOURCE OF INFORMATION U-487

DRILLER or DIGGER Pat McGinley

ADDITIONAL DATA:

Log x Water Level Measurements Chemical Analysis Aquifer Test

REMARKS:

used for irrigating lawn

