

KLAM 12894

STATE ENGINEER
Salem, Oregon

KLAM
12894

Well Record

STATE WELL NO. 39/10-8J(2)
COUNTY Klamath
APPLICATION NO. U-487

OWNER: Mt. Calvary Cemetery Ass'n. Inc. MAILING ADDRESS: 815 High Street

LOCATION OF WELL: Owner's No. 1 CITY AND STATE: Klamath Falls, Oregon

NE 1/4 SE 1/4 Sec. 8 T. 39 N. S., R. 10 E. W., W.M.

Bearing and distance from section or subdivision corner

Altitude at well

TYPE OF WELL: Drilled Date Constructed

Depth drilled Depth cased

			0 J2

Section 8

CASING RECORD:

FINISH:

AQUIFERS:

WATER LEVEL:

56.87 feet below land surface December 8, 1954

PUMPING EQUIPMENT: Type H.P.
Capacity G.P.M.

WELL TESTS:

Drawdown ft. after hours G.P.M.

Drawdown ft. after hours G.P.M.

USE OF WATER Irrigation Temp. °F., 19.....

SOURCE OF INFORMATION

DRILLER or DIGGER

ADDITIONAL DATA:

Log Water Level Measurements Chemical Analysis Aquifer Test

REMARKS:

Listed as 8 R1 in USGS Report

STATE ENGINEER
Salem, Oregon

KLAM **KLAM 12894**
12894 **Well Record**

STATE WELL NO. 39/10-8R1
COUNTY Klamath
APPLICATION NO.

OWNER: Mt. Calvary Cemetery


MAILING ADDRESS:

LOCATION OF WELL: Owner's No.

CITY AND STATE:

..... $\frac{1}{4}$ $\frac{1}{4}$ Sec. T. N. E.
S., R. W., W.M.

Bearing and distance from section or subdivision corner

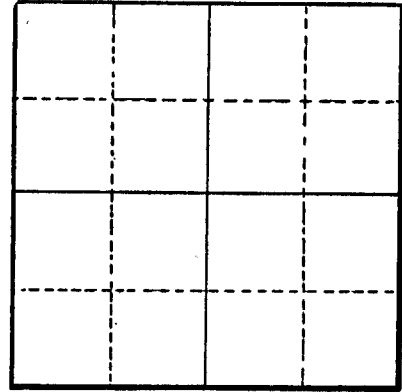

Section

Altitude at well 4,190

TYPE OF WELL: Drilled Date Constructed

Depth drilled 500 Depth cased

CASING RECORD:

8 inch

FINISH:

AQUIFERS:

WATER LEVEL:

56.87 feet below land surface on December 8, 1954

PUMPING EQUIPMENT: Type Turbine H.P.
Capacity 40 G.P.M.

WELL TESTS:

Drawdown ft. after hours G.P.M.
Drawdown ft. after hours G.P.M.

USE OF WATER Irrigation Temp. °F., 19....

SOURCE OF INFORMATION USGS

DRILLER or DIGGER

ADDITIONAL DATA:

Log Water Level Measurements Chemical Analysis Aquifer Test

REMARKS:

Located 500 ft. south of well -8J1.