

STATE ENGINEER  
Salem, Oregon

*13283*  
**Well Record**

STATE WELL NO. 39/10-28Q1  
COUNTY Klamath  
APPLICATION NO.

OWNER: Glen Dehlinger MAILING ADDRESS: \_\_\_\_\_

LOCATION OF WELL: Owner's No. \_\_\_\_\_ CITY AND STATE: \_\_\_\_\_


\_\_\_\_\_ 1/4 \_\_\_\_\_ 1/4 Sec. \_\_\_\_\_ T. \_\_\_\_\_ N. \_\_\_\_\_ E. \_\_\_\_\_ S., R. \_\_\_\_\_ W., W.M.

Bearing and distance from section or subdivision corner \_\_\_\_\_

Altitude at well 4,119

TYPE OF WELL: Drilled Date Constructed \_\_\_\_\_

Depth drilled 350 Depth cased \_\_\_\_\_

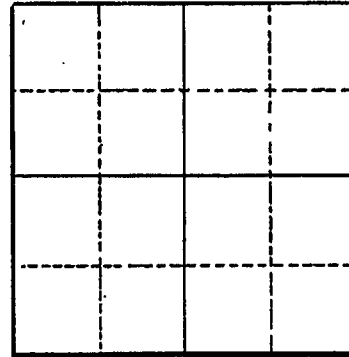

Section \_\_\_\_\_

**CASING RECORD:**

6 inch

**FINISH:**

**AQUIFERS:**

Basalt from 348 to 350

**WATER LEVEL:**

Flowing well, December 10, 1954

PUMPING EQUIPMENT: Type Centrifugal H.P. \_\_\_\_\_  
Capacity 25 G.P.M.

**WELL TESTS:**

Drawdown \_\_\_\_\_ ft. after \_\_\_\_\_ hours \_\_\_\_\_ G.P.M.

Drawdown \_\_\_\_\_ ft. after \_\_\_\_\_ hours \_\_\_\_\_ G.P.M.

USE OF WATER Domestic, stock Temp. \_\_\_\_\_ °F. \_\_\_\_\_, 19\_\_\_\_

SOURCE OF INFORMATION USGS

DRILLER or DIGGER \_\_\_\_\_

**ADDITIONAL DATA:**

Log \_\_\_\_\_ Water Level Measurements \_\_\_\_\_ Chemical Analysis \_\_\_\_\_ Aquifer Test \_\_\_\_\_

**REMARKS:**

Penetrated 348 ft. of "chalk rock" and 2 ft. of basalt above aquifer; flows about 30 gpm.

This copy is from Application file U-250  
Permit U-240  
Append to well log 13783

(Glenn Dehlinger)

### LOG OF GLENN DEHLINGER WELL

Location ---SE $\frac{1}{4}$ -SE $\frac{1}{4}$ , Section 28, T. 39 S., R. 10 E., W.M.

Drillers ---Bill Hartley

Bob Hartley

Diameter ---6 inch

Casing Installed --- 80 feet

0 - 3 ft. Top Soil

3 - 348 Chalk

348 - 350 Rock

350 Chalk with water under pressure

Natural flow of well - 50 G.P.M.