

STATE ENGINEER
Salem, Oregon

KLAM 13391
Well Record

STATE WELL NO. 39/11-10M(1)
COUNTY Klamath
APPLICATION NO.

OWNER: Bonanza School


MAILING ADDRESS:

LOCATION OF WELL: Owner's No.

CITY AND STATE:

NW SW 10 39 E. 11
1/4 1/4 Sec. T. S., R. W., W.M.

Bearing and distance from section or subdivision corner

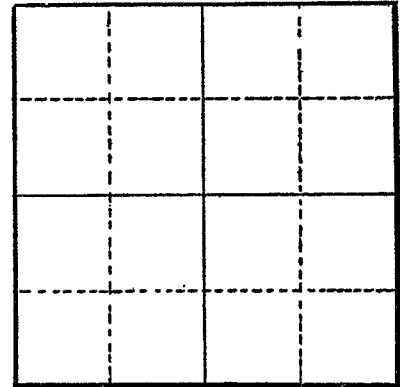

Section

Altitude at well 4,140

TYPE OF WELL: Drilled Date Constructed

Depth drilled 90 Depth cased 40 ft.

CASING RECORD: 8 inches, 40 ft.

FINISH:

AQUIFERS: Gray cinders from 88 ft. to 90 ft.

WATER LEVEL: 31+ feet below land surface, 1948

PUMPING EQUIPMENT: Type centrifugal H.P.
Capacity G.P.M.

WELL TESTS:
Drawdown ft. after hours G.P.M.
Drawdown ft. after hours G.P.M.

USE OF WATER Domestic Temp. °F., 19

SOURCE OF INFORMATION USGS

DRILLER or DIGGER

ADDITIONAL DATA:
Log Water Level Measurements Chemical Analysis Aquifer Test

REMARKS: Hardness 60ppm, chloride 3ppm.

