

STATE ENGINEER
Salem, Oregon

KLAM
13397

OBSERVATION WELL
Well Record

STATE WELL NO. 39/11-10R(1)
COUNTY Klamath
APPLICATION NO. U-488

OWNER: LOST RIVER CEMETERY

MAILING ADDRESS: BAWANZA

LOCATION OF WELL: Owner's No.

CITY AND STATE:

SE 1/4 SE 1/4 Sec. 10 T. 39 N. S. R. 11 E. W.M.

Bearing and distance from section or subdivision

corner


Altitude at well ± 4120

TYPE OF WELL: DRILLED Date Constructed

Depth drilled 238' Depth cased

CASING RECORD:

12 inch

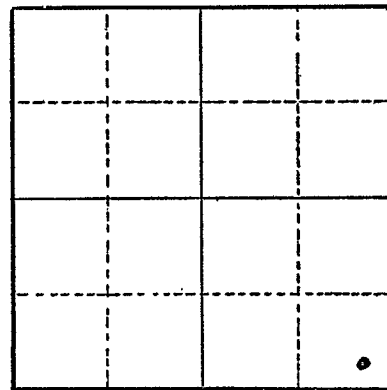

Section 10

FINISH:

AQUIFERS:

WATER LEVEL:

14.25' (5-1-63)

PUMPING EQUIPMENT: Type JOHNSTON TURBINE H.P. 15
Capacity G.P.M.

WELL TESTS:

Drawdown ft. after hours G.P.M.

Drawdown ft. after hours G.P.M.

USE OF WATER IRRIGATION Temp. °F. 19

SOURCE OF INFORMATION U-488

DRILLER or DIGGER

ADDITIONAL DATA:

Log NA Water Level Measurements ✓ Chemical Analysis Aquifer Test

REMARKS: