

STATE ENGINEER
Salem, Oregon

Klamath Well Record
13428


STATE WELL NO. *39/11-21H(1)*
COUNTY *Klamath*
APPLICATION NO. *U-411*

OWNER: *M. & Verna Sewald* MAILING ADDRESS: _____

LOCATION OF WELL: Owner's No. *1* CITY AND STATE: *Bonanza, Oregon*

SE 1/4 NE 1/4 Sec. *21* T. *39* S., R. *11* W., W.M.

Bearing and distance from section or subdivision corner *S. 03° 21' W. 2327' from NE cor. Sec. 21*

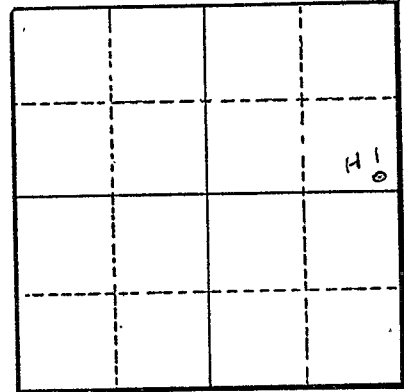

Section *21*

Altitude at well _____

TYPE OF WELL: *Drilled* Date Constructed _____

Depth drilled *200* Depth cased _____

CASING RECORD:

15 inch

FINISH:

AQUIFERS:

45 feet below land surface 1951

WATER LEVEL:

PUMPING EQUIPMENT: Type *Turbine* H.P. *60*
Capacity *100* G.P.M.

WELL TESTS:

Drawdown *to 135* ft. after *336* hours *pumping 1,000* G.P.M.
Drawdown _____ ft. after _____ hours _____ G.P.M.

USE OF WATER *Irrigation* Temp. _____ °F. _____, 19____

SOURCE OF INFORMATION *U-411*

DRILLER or DIGGER _____

ADDITIONAL DATA:

Log _____ Water Level Measurements _____ Chemical Analysis _____ Aquifer Test _____

REMARKS: