

STATE ENGINEER  
Salem, Oregon

*KLAM*  
*13465*

# Well Record

STATE WELL NO. *39/11-57(1)*  
COUNTY *Klamath*  
APPLICATION NO. *V228-021*

OWNER: *L.L. Porterfield*


MAILING ADDRESS: \_\_\_\_\_

LOCATION OF WELL: Owner's No. *2*

CITY AND STATE: \_\_\_\_\_

~~NW~~ NW *5* *39* N. *11 1/2* E.  
~~SW~~ *1/4* *1/4* Sec. T. S. R. W., W.M.

Bearing and distance from section or subdivision corner  
*N 45° E - 1065' from*  
*W 1/4 corner section 5*

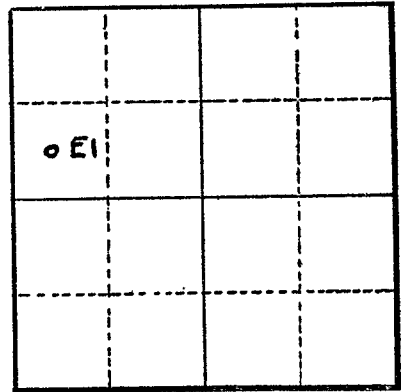

Section *5*

Altitude at well *4,205*

TYPE OF WELL: *Drilled* Date Constructed \_\_\_\_\_

Depth drilled *260* Depth cased *21 ft.*

CASING RECORD: *16 inches, 21 ft.*

FINISH: \_\_\_\_\_

AQUIFERS: *Basalt from 150 ft. to 260 ft.*

WATER LEVEL: *93.67 feet below land surface, November 19, 1949*

PUMPING EQUIPMENT: Type *Turbine* H.P. \_\_\_\_\_  
Capacity \_\_\_\_\_ G.P.M.

WELL TESTS:  
Drawdown *2.5* ft. after *4* hours *pumping 1800* G.P.M.  
Drawdown \_\_\_\_\_ ft. after \_\_\_\_\_ hours \_\_\_\_\_ G.P.M.

USE OF WATER *Irrigation* Temp. *56* °F. *Jun. 20*, 19*49*

SOURCE OF INFORMATION *USGS*  
DRILLER or DIGGER *Pat McGinley*

ADDITIONAL DATA:  
Log  Water Level Measurements \_\_\_\_\_ Chemical Analysis \_\_\_\_\_ Aquifer Test \_\_\_\_\_

REMARKS: *Yielded*  
*1,800 gpm with drawdown of 25 ft. after 4 hours. Drainage recharged into well, 1952.*

