

STATE ENGINEER
Salem, Oregon

Klam Well Record
13490

STATE WELL NO. *39/11 1/2-22J(1)*
COUNTY *Klamath*
APPLICATION NO. *U-394*

OWNER: *P Hatchett*


MAILING ADDRESS: *Route 2, Box 797*

LOCATION OF WELL: Owner's No. _____

CITY AND STATE: *Klamath Falls, Oregon*

NE 1/4 SE 1/4 Sec. 22 T. 39 N. S. R. 11 1/2 W., W.M.

Bearing and distance from section or subdivision
corner *S 43° 08' W 781' from E 1/4 cor. Sec. 22*

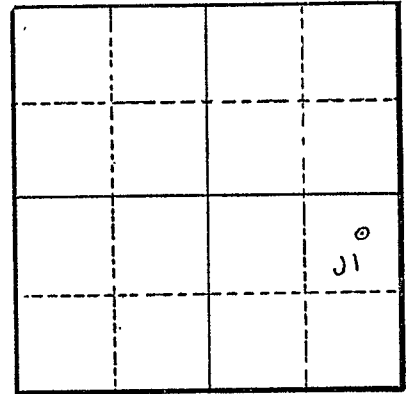

Section *22*

Altitude at well *4205'*

TYPE OF WELL: *Drilled* Date Constructed _____

Depth drilled *900* Depth cased *40*

CASING RECORD:

12 inch

FINISH:

AQUIFERS:

Lava rock

WATER LEVEL:

85 feet below land surface November 20, 1949

PUMPING EQUIPMENT: Type *Turbine* H.P. _____
Capacity *800* G.P.M.

WELL TESTS:

Drawdown *5* ft. after _____ hours *800* G.P.M.
Drawdown _____ ft. after _____ hours _____ G.P.M.

USE OF WATER *Irrigation 160 a. Dom & Temp.* °F. _____, 19_____

SOURCE OF INFORMATION *USGS* *Stk.*

DRILLER or DIGGER _____

ADDITIONAL DATA:

Log Water Level Measurements _____ Chemical Analysis _____ Aquifer Test _____

REMARKS:

