


Well Record

OWNER: *U. S. Bureau of Reclamation* MAILING ADDRESS: _____

LOCATION OF WELL: Owner's No. _____ CITY AND STATE: _____

..... $\frac{1}{4}$ $\frac{1}{4}$ Sec. T. N. E.
S, R. W., W.M.

Bearing and distance from section or subdivision corner _____

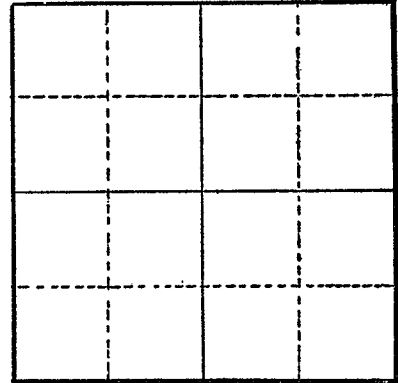

Section _____

Altitude at well *4,870*

TYPE OF WELL: *Drilled* Date Constructed _____

Depth drilled *260* Depth cased _____

CASING RECORD:

6 inch

FINISH:

AQUIFERS:

WATER LEVEL:

230⁺ feet below land surface, *1954*

PUMPING EQUIPMENT: Type *Plunger* H.P. _____
Capacity *5* G.P.M.

WELL TESTS:

Drawdown ft. after hours G.P.M.
Drawdown ft. after hours G.P.M.

USE OF WATER *Domestic* Temp. °F., 19.....

SOURCE OF INFORMATION *USGS*

DRILLER or DIGGER _____

ADDITIONAL DATA:

Log Water Level Measurements Chemical Analysis Aquifer Test

REMARKS:

Supplies caretaker's house at Gerber Reservoir.