

STATE ENGINEER  
Salem, Oregon

KLAM  
1362

OBSERVATION WELL  
Well Record

STATE WELL NO. 357-341  
COUNTY Klamath  
APPLICATION NO.

H.C. SPICER

OWNER: Mrs. Elsie Burton


MAILING ADDRESS:

LOCATION OF WELL: Owner's No.

CITY AND STATE:

1/4 1/4 Sec. T. N. S., R. E. W., W.M.

Bearing and distance from section or subdivision corner

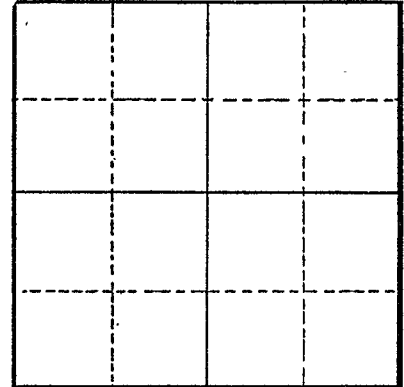

Section

Altitude at well 4,160

TYPE OF WELL: Drilled Date Constructed

Depth drilled 510 - CAVED TO 177 Depth cased 156

CASING RECORD:

12 inch

FINISH:

AQUIFERS:

Pea gravel from 175 to 178

WATER LEVEL:

12 feet below land surface on 9/ /50

PUMPING EQUIPMENT: Type Turbine

H.P.

Capacity 640 G.P.M.

WELL TESTS:

Drawdown ft. after hours G.P.M.

Drawdown ft. after hours G.P.M.

USE OF WATER Irrigation Temp. °F., 19

SOURCE OF INFORMATION USGS

DRILLER or DIGGER

ADDITIONAL DATA:

Log X Water Level Measurements Chemical Analysis Aquifer Test

REMARKS:

Test-pumped 1,500 gpm with 73 ft. of drawdown.

