

STATE ENGINEER
Salem, Oregon

Klam
13620

Well Record

STATE WELL NO. *39/13-3001*
COUNTY *Klamath*
APPLICATION NO.

OWNER: *M. D. Settle*


MAILING ADDRESS:

LOCATION OF WELL: Owner's No.

CITY AND STATE:

..... $\frac{1}{4}$ $\frac{1}{4}$ Sec. T. N. E.
S., R. W., W.M.

Bearing and distance from section or subdivision corner

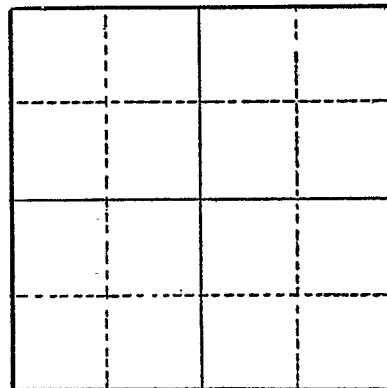

Section

Altitude at well *4,300*

TYPE OF WELL: *Drilled* Date Constructed

Depth drilled *280* Depth cased *164*

CASING RECORD:

16 inch

FINISH:

AQUIFERS:

Basalt

WATER LEVEL:

Flowing well, August 5, 1954

PUMPING EQUIPMENT: Type *Turbine* H.P.
Capacity *230* G.P.M.

WELL TESTS:

Drawdown ft. after hours G.P.M.
Drawdown ft. after hours G.P.M.

USE OF WATER *Irrigation* Temp. °F., 19....

SOURCE OF INFORMATION *USGS*

DRILLER or DIGGER

ADDITIONAL DATA:

Log Water Level Measurements Chemical Analysis Aquifer Test

REMARKS:

Irrigates 40 acres; penetrated basalt, a section of sedimentary rock, then aquifer.