

STATE ENGINEER
Salem, Oregon

KUM
14102

Well Record

STATE WELL NO. 39/8-1P1
COUNTY Klamath
APPLICATION NO.

OWNER: Charles M. Ohles


MAILING ADDRESS:

LOCATION OF WELL: Owner's No.

CITY AND STATE:

..... 1/4 1/4 Sec. T. N. E. S., R. W., W.M.

Bearing and distance from section or subdivision corner

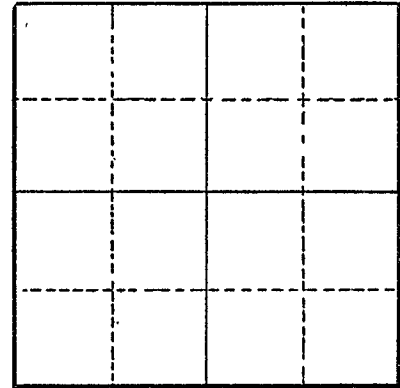

Section

Altitude at well 4,175

TYPE OF WELL: Drilled Date Constructed

Depth drilled 148 Depth cased

CASING RECORD:
12 inch

FINISH:

AQUIFERS:

"Gravel"

WATER LEVEL:

50 feet below land surface , 1948

PUMPING EQUIPMENT: Type Turbine H.P.
Capacity 350 G.P.M.

WELL TESTS:

Drawdown ft. after hours G.P.M.
Drawdown ft. after hours G.P.M.

USE OF WATER Irrigation Temp. °F. , 19

SOURCE OF INFORMATION USGS

DRILLER or DIGGER

ADDITIONAL DATA:

Log Water Level Measurements Chemical Analysis Aquifer Test

REMARKS:

Irrigates 80 acres by sprinklers.