

KLAM 14714

STATE ENGINEER
Salem, Oregon

*KLAM
14714*

Well Record

STATE WELL NO. 40/11-11
COUNTY Klamath
APPLICATION NO. G-1252

OWNER: Francis Oscar & Margaret
Willnetta FREUER


MAILING ADDRESS: Rt. 2, Box 788

LOCATION OF WELL: Owner's No. _____

CITY AND STATE: Klamath, Falls, Oregon

NE 1/4 SE 1/4 Sec. 1 T. 40 S., R. 11 E., W.M.

Bearing and distance from section or subdivision
corner 1°W. of N., 1547' from SE cor. of
section 5.

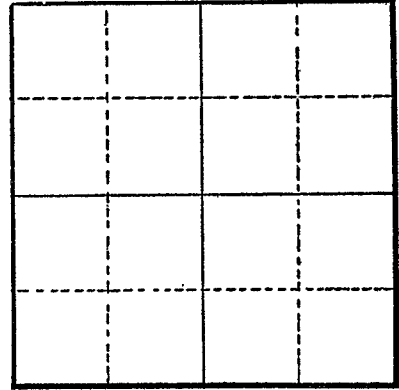

Section 1

Altitude at well 4442 ft.

TYPE OF WELL: Drilled Date Constructed 1952

Depth drilled 240 ft. Depth cased 20 ft.

CASING RECORD:

14 inch from surface to 20 ft.

FINISH:

AQUIFERS:

WATER LEVEL:
Flowing

PUMPING EQUIPMENT: Type Berkeley 4X5 H.P. 3
Capacity _____ G.P.M.

WELL TESTS:

Drawdown 14 ft. after _____ hours 600 G.P.M.
Drawdown 95 ft. after _____ hours 1000 G.P.M.

USE OF WATER Irrigation Temp. _____ °F., 19____

SOURCE OF INFORMATION Related registration statement

DRILLER or DIGGER Eldon Storey

ADDITIONAL DATA:

Log Water Level Measurements _____ Chemical Analysis _____ Aquifer Test _____

REMARKS:

KLAM 14714

STATE ENGINEER
Salem, Oregon

KLAM 14714
Well Record

STATE WELL NO. *40/12-6G1*
COUNTY *Klamath*
APPLICATION NO.

OWNER: *F. O. Freuer* MAILING ADDRESS:

LOCATION OF WELL: Owner's No. CITY AND STATE:


..... $\frac{1}{4}$ $\frac{1}{4}$ Sec. T. N. S., R. E. W., W.M.

Bearing and distance from section or subdivision corner

Altitude at well *4,225*

TYPE OF WELL: *Drilled* Date Constructed

Depth drilled *240* Depth cased *20*

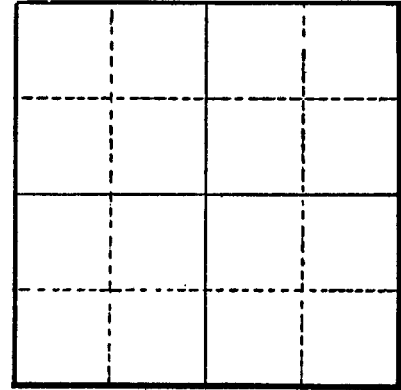

Section

CASING RECORD:

14 inch

FINISH:

AQUIFERS: *Basalt from 150 to 160*
215 to 238

WATER LEVEL:

Flowing well, August 21, 1954

PUMPING EQUIPMENT: Type *None* H.P.
Capacity G.P.M.

WELL TESTS:

Drawdown ft. after hours G.P.M.
Drawdown ft. after hours G.P.M.

USE OF WATER *None* Temp. °F., 19.....

SOURCE OF INFORMATION *USGS*

DRILLER or DIGGER

ADDITIONAL DATA:

Log *X* Water Level Measurements Chemical Analysis *X* Aquifer Test

REMARKS:

Owner reports flow about 250 gpm; water level draws down to 80 ft. when pumped at 1,000 gpm for 5 hrs; water to be used for irrigation.

STATE ENGINEER
Salem, Oregon

KLAM 14714

State Well No. 40/12-6G1

County Klamath

Application No.

Chemical Analysis

OWNER F. D. Freuer OWNER'S NO.

ANALYST U.S. Geological Survey Address

Date of Collection 2-18-55

Point of Collection

	P.P.M.	E.P.M.
Silica (SiO ₂)	27.	
Iron (Fe) Total	.01	
Manganese (Mn)		
Calcium (Ca)	20.	
Magnesium (Mg)	11.	
Sodium (Na)	21.	
Potassium (K)	3.4	
Bicarbonate (HCO ₃)	166.	
Carbonate (CO ₃)	XX	
Sulfate (SO ₄)	5.1	
Chloride (Cl)	1.8	
Fluoride (F)	.1	
Nitrate (NO ₃)	3.4	
Boron (B)	.05	
Dissolved Solids	168.	
Hardness as CaCO ₃	95.	
Specific Conductance (Micromhos at 25°C)	269.	
pH	8.1	
Percent Sodium	31.	
Sodium Absorption Ratio (S.A.R.)	.9	
CLASS		



Oregon Water Resources Department
725 Summer Street NE, Suite A
Salem Oregon 97301
(503) 986-0900
www.oregon.gov/owrd

Application for
Well ID Number

RECEIVED

APR 29 2020

OWRD

Do not complete if the well already has a Well Identification Number.

I. OWNER INFORMATION

Current Owner Name (please print): ANNA CORNACCHIOLI

Mailing Address: 5926 CAMELLIA AVE

City, State, Zip: SACRAMENTO, CA 95819

Mail Well ID to: [] SAME AS ABOVE [X] In Care Of (C/O)

Name & Address: ANNA CORNACCHIOLI 10605 HARPOLD RD

City, State, Zip: KLAMATH FALLS, OR 97603

II. WELL LOCATION INFORMATION (Please fill out as completely as possible)

Township: 40 S (North / South) Range: 11 E (East / West) Section: 1 NE 1/4 of the NE 1/4

Tax Lot (usually last 3-5 numbers of Tax Map #): 200 County KLAMATH

GPS Coordinates: 42.12651773; -121.46379950 (per GWIS site)

Street Address of Well, City: 10605 HARPOLD RD

If the property had a different street address in the past:

III. GENERAL WELL INFORMATION (Please fill out as completely as possible, AND attach copy of Well Report, if available)

Use of Well (domestic, irrigation, commercial, industrial, monitoring): IRRIGATION

Date Well Constructed (or property built): 1952 Total Well Depth: 344' Casing Diameter: 14"

Owner at time the well was constructed (if known): FRANCIS & MARGARET FREUER Well Report # (if known): KLAM 14714

Other Information: Orig 240'; Deepened to 344' in 1965: KLAM 13630 (Incorrectly marked in adjacent TRS 40 s 12 e 6

SUBMITTED BY (please print): ANNA CORNACCHIOLI (VIA PHONE)

PHONE: 916-717-4670 EMAIL &/or FAX:

Send application to: Oregon Water Resources Department 725 Summer St NE, Suite A, Salem, Oregon 97301; or fax to (503) 986-0902. Applications are processed in the order they are received, and Well ID Numbers are mailed within 4-5 business days.

For Official Use Only by the Oregon Water Resources Department:

Received Date: 4-29-2020

Well Report Number: KLAM 14714 (ORIG) KLAM 13630 (DEEPENING)

Well Identification #: L-137450