

STATE ENGINEER  
Salem, Oregon

Klamath  
14844

# Well Record

STATE WELL NO. 40/12-34P1  
COUNTY Klamath  
APPLICATION NO.

OWNER: C. G. Gross


MAILING  
ADDRESS:

LOCATION OF WELL: Owner's No.

CITY AND  
STATE:

1/4 Sec. T. N. S., R. E. W., W.M.

Bearing and distance from section or subdivision  
corner

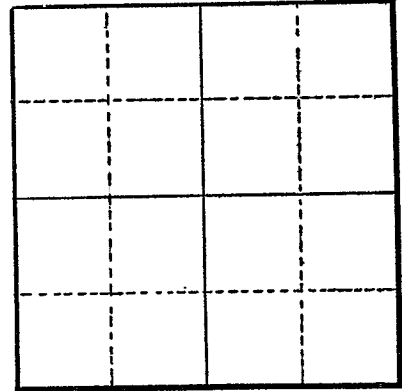

Section

Altitude at well 4,155

TYPE OF WELL: Drilled Date Constructed

Depth drilled 625 Depth cased

### CASING RECORD:

16 inch

### FINISH:

### AQUIFERS:

Basalt

### WATER LEVEL:

142<sup>+</sup> feet below land surface, 1954

PUMPING EQUIPMENT: Type Turbine H.P.  
Capacity 1,000 G.P.M.

### WELL TESTS:

Drawdown ft. after hours G.P.M.  
Drawdown ft. after hours G.P.M.

USE OF WATER Irrigation Temp. °F., 19.

SOURCE OF INFORMATION USGS

DRILLER or DIGGER

### ADDITIONAL DATA:

Log Water Level Measurements Chemical Analysis Aquifer Test

### REMARKS:

Water cascades into well from perched water body at 87 ft.