

STATE ENGINEER
Salem, Oregon

Klamath
~~14935~~ **KLAM 14939**
Well Record
14929


STATE WELL NO. *FN* 41/10-6H
COUNTY Klamath
APPLICATION NO.

OWNER: M. J. Barnes MAILING ADDRESS:

LOCATION OF WELL: Owner's No. CITY AND STATE:

..... 1/4 1/4 Sec. T. N. S., R. E. W., W.M.

Bearing and distance from section or subdivision corner

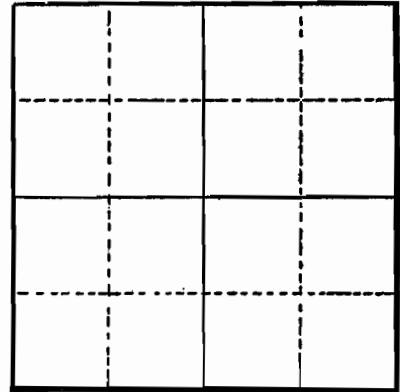

Section

Altitude at well 4,200

TYPE OF WELL: Drilled Date Constructed

Depth drilled 330 Depth cased

CASING RECORD:

12 inch

FINISH:

AQUIFERS:

Gravel, coarse

WATER LEVEL:

118 feet below land surface, 1954

PUMPING EQUIPMENT: Type Turbine H.P.
Capacity 1,000 G.P.M.

WELL TESTS:

Drawdown ft. after hours G.P.M.
Drawdown ft. after hours G.P.M.

USE OF WATER Irrigation Temp. °F., 19

SOURCE OF INFORMATION USGS

DRILLER or DIGGER

ADDITIONAL DATA:

Log Water Level Measurements Chemical Analysis Aquifer Test

REMARKS:

Water level draws down about 40 ft. when pumped at 1,000 gpm.

From: Karl Wozniak
Sent: Thursday, October 21, 2010 10:09 AM
To: Mary Rohling
Cc: Linda Tippett
Subject: KLAM 14929, 14934

Mary and Linda,

These logs represent the same well. Can we merge them under KLAM 14929? This is the logid that the Groundwater section and the USGS use to refer to this well.

Karl Wozniak
Hydrogeologist
Oregon Water Resources Dept
725 Summer St NE Suite A
Salem, OR 97301
503-986-0843