

*Klamath*  
*14945*  
*6/24*

**WATER WELL DRILLERS REPORT**  
**STATE OF OREGON**

Do Not  
Fill In  
State Well No. 11/10-9 L (1)  
State Permit No. U-354

**(1) OWNER:**

Name Wendell Moore  
Address Merrill, Oregon

**(2) LOCATION OF WELL: Application # U-379**

County Klamath Owner's number, if any—  
R. E. D. or Street No. \_\_\_\_\_  
Bearing and distance from section or subdivision corner  
N. 22° 18' W. - 2606 ft. from S $\frac{1}{2}$  corner  
Section 9  
NE $\frac{1}{4}$  Sec. 9, T. 11 S., R. 10 E.

**(3) TYPE OF WORK (check):**

Drill new well  Deepening  Reconditioning  Abandon   
If abandonment, describe material and procedure in Item 11.

**(4) PROPOSED USE (check):**

Domestic  Industrial  Municipal   
Irrigation  Test Well  Other

**(5) EQUIPMENT:**

Rotary   
Cable   
Dug Well

**(6) CASING INSTALLED:**

FROM	ft. to	Diam.	ft.	Gage or Wall	Diameter of Bore	from ft.	to ft.
	0	21	12"				
"	"	"	"	"	"	"	"
"	"	"	"	"	"	"	"
"	"	"	"	"	"	"	"
"	"	"	"	"	"	"	"
"	"	"	"	"	"	"	"
"	"	"	"	"	"	"	"

If gravel packed

Type and size of shoe or well ring \_\_\_\_\_ Size of gravel: \_\_\_\_\_  
Describe joint \_\_\_\_\_

**(7) PERFORATIONS:**

Type of perforator used \_\_\_\_\_

SIZE of perforations	in., length, by	in.
FROM ft. to ft.	perf per foot	No. of rows
" " "	" " "	" " "
" " "	" " "	" " "
" " "	" " "	" " "
" " "	" " "	" " "

**SCREENS:**

Give Manufacturer's Name, Model No. and Size \_\_\_\_\_

**(8) CONSTRUCTION:**

Was a surface sanitary seal provided?  Yes  No To what depth \_\_\_\_\_ ft.  
Were any strata sealed against pollution?  Yes  No  
If yes, note depth of strata \_\_\_\_\_ ft.  
FROM \_\_\_\_\_ ft. to \_\_\_\_\_ ft.

**METHOD OF SEALING**

**(9) WATER LEVELS:**

Depth at which water was first found \_\_\_\_\_ ft.  
Standing level before perforating \_\_\_\_\_ ft.  
Standing level after perforating \_\_\_\_\_ ft.

Log Accepted by: \_\_\_\_\_

[Signed] \_\_\_\_\_ Dated \_\_\_\_\_, 19\_\_\_\_  
Owner

**(10) WELL TESTS:**

Was a pump test made?  Yes  No If yes, by whom?  
Yield: 1600 gal./min. with 10 ft. draw down after 6 hrs.  
" 2200 " 70 " " "  
" " " " "  
Artesian flow \_\_\_\_\_ g.p.m.  
Shut-in pressure \_\_\_\_\_ lbs. per square inch.  
Boiler test \_\_\_\_\_ g.p.m. with \_\_\_\_\_ ft. drawdown  
Temperature of water \_\_\_\_\_ Was a chemical analysis made?  Yes  No  
Was electric log made of well?  Yes  No

**(11) WELL LOG:**

Diameter of well, \_\_\_\_\_ inches.  
Total depth \_\_\_\_\_ ft. Depth of completed well \_\_\_\_\_ ft.

Formation: Describe by color, character, size of material and structure, and show thickness of aquifers and the kind and nature of the material in each stratum penetrated, with at least one entry for each change of formation.

0 ft. to	20 ft.	Soil, Clay and Gravel
20 "	35 "	Chalkrock, yellow
35 "	50 "	Sand rock, black, waterbearing
50 "	65 "	Chalkrock, yellow
65 "	175 "	Chalkrock, blackish
175 "	210 "	Cinders, black
210 "	216 "	Sandrock, black
216 "	600 "	Chalkrock, brown
600 "	700 "	Sand, black, waterbearing
700 "	715 "	Rock, some gravel & sand
715 "	783 "	Sand

Ground elevation at well site \_\_\_\_\_ feet above mean sea level.  
Work started 19 49 Completed 19 \_\_\_\_\_

**Well Driller's Statement:**

This well was drilled under my jurisdiction and this report is true to the best of my knowledge and belief.

NAME V. Wilson  
(Person, firm, or corporation) (Typed or printed)

Address \_\_\_\_\_  
Driller's well number \_\_\_\_\_

[Signed] \_\_\_\_\_ (Well Driller)

License No. \_\_\_\_\_ Dated \_\_\_\_\_, 19\_\_\_\_

STATE ENGINEER  
Salem, Oregon

Klam  
4945

# Well Record

STATE WELL NO. 41/10-911  
COUNTY Klamath  
APPLICATION NO. \_\_\_\_\_

OWNER: Wendel Moore

MAILING  
ADDRESS: \_\_\_\_\_

LOCATION OF WELL: Owner's No. \_\_\_\_\_

CITY AND  
STATE: \_\_\_\_\_


\_\_\_\_\_ 1/4 \_\_\_\_\_ 1/4 Sec. \_\_\_\_\_ T. \_\_\_\_\_ N. \_\_\_\_\_ E.  
S., R. \_\_\_\_\_ W., W.M.

Bearing and distance from section or subdivision  
corner \_\_\_\_\_

Altitude at well 4.120

TYPE OF WELL: Drilled Date Constructed \_\_\_\_\_

Depth drilled 781 Depth cased 21

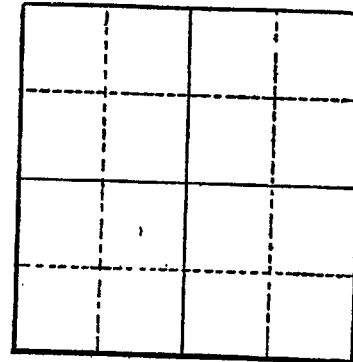

Section \_\_\_\_\_

### CASING RECORD:

12 inch

### FINISH:

### AQUIFERS:

Sand from 600 to 781

### WATER LEVEL:

48 feet below land surface, March, 1949

PUMPING EQUIPMENT: Type Turbine

Capacity 2,200 G.P.M.

H.P. \_\_\_\_\_

### WELL TESTS:

Drawdown \_\_\_\_\_ ft. after \_\_\_\_\_ hours \_\_\_\_\_ G.P.M.

Drawdown \_\_\_\_\_ ft. after \_\_\_\_\_ hours \_\_\_\_\_ G.P.M.

USE OF WATER Irrigation

Temp. \_\_\_\_\_ °F. \_\_\_\_\_, 19\_\_\_\_

SOURCE OF INFORMATION USGS

DRILLER or DIGGER \_\_\_\_\_

### ADDITIONAL DATA:

Log  Water Level Measurements \_\_\_\_\_ Chemical Analysis \_\_\_\_\_ Aquifer Test \_\_\_\_\_

### REMARKS:

Water level draws down about 70 ft. when pumped at 2,200 gpm.

