

STATE ENGINEER
Salem, Oregon

KLAM
15093

Well Record


STATE WELL NO. *41/12-15M*
COUNTY *Klamath*
APPLICATION NO. *GR-4060*

OWNER: *Malin Municipal Water System* MAILING ADDRESS: _____

LOCATION OF WELL: Owner's No. _____ CITY AND STATE: *Malin, Oregon*

NW $\frac{1}{4}$ SW $\frac{1}{4}$ Sec. *15* T. *41* N. S. R. *12* E. W., W.M.

Bearing and distance from section or subdivision corner *75° 55' E., 685 ft. 9 1/2 inches*

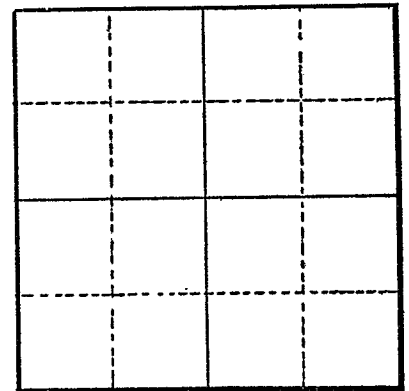

Section _____

Altitude at well _____

TYPE OF WELL: *Drilled* Date Constructed *1931*

Depth drilled *370 feet* Depth cased *100 feet*

CASING RECORD:

8-inch

FINISH:

AQUIFERS:

soil, rocks, sand, clay

WATER LEVEL:

21 feet

PUMPING EQUIPMENT: Type *Peerless Pump* H.P. *10*
Capacity _____ G.P.M.

WELL TESTS:

Drawdown _____ ft. after _____ hours _____ G.P.M.
Drawdown _____ ft. after _____ hours _____ G.P.M.

USE OF WATER *Municipal, city of Malin* Temp. _____ °F. _____, 19____
SOURCE OF INFORMATION *GR-2895*

DRILLER or DIGGER _____

ADDITIONAL DATA:

Log Water Level Measurements _____ Chemical Analysis _____ Aquifer Test _____

REMARKS:

Soil 0 5 5
Rocks intermingled 5 100 95
with sand and clay layers, caves readily
Lava rock and strates of Honey-comb Lava Rock 100 370 270
Heavy black water sand 370 10