

STATE ENGINEER  
Salem, Oregon

*12/AM*  
*15094*

# Well Record

STATE WELL NO. *41/12-15F1*  
COUNTY *Klamath*  
APPLICATION NO. ....

OWNER: *Town of Malin*


MAILING ADDRESS: .....

LOCATION OF WELL: Owner's No. ....

CITY AND STATE: .....

.....  $\frac{1}{4}$  .....  $\frac{1}{4}$  Sec. .... T. .... N. S., R. .... E. W., W.M.

Bearing and distance from section or subdivision corner .....

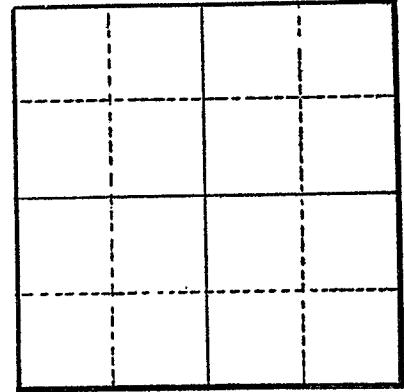

Section .....

Altitude at well *4,066*

TYPE OF WELL: *Drilled* Date Constructed .....

Depth drilled *324* Depth cased .....

### CASING RECORD:

*8 inch*

### FINISH:

### AQUIFERS:

*Sand and gravel (?)*

### WATER LEVEL:

*21 feet below land surface, 1943*

PUMPING EQUIPMENT: Type *Turbine* ..... H.P. ....  
Capacity *500* ..... G.P.M. ....

### WELL TESTS:

Drawdown ..... ft. after ..... hours ..... G.P.M.  
Drawdown ..... ft. after ..... hours ..... G.P.M.

USE OF WATER *Public Supply* ..... Temp. .... °F. ...., 19....

SOURCE OF INFORMATION *USGS* .....

DRILLER or DIGGER .....

ADDITIONAL DATA:  
Log ..... Water Level Measurements ..... Chemical Analysis ..... Aquifer Test .....

### REMARKS:

*City well No. 1; superintendent reports material above aquifer mostly clay and silt.*