

STATE ENGINEER  
Salem, Oregon

*Klamath*  
*15095*

# Well Record

STATE WELL NO. *41/12-15F2*  
COUNTY *Klamath*  
APPLICATION NO. ....

OWNER: *Town of Malin* MAILING ADDRESS: .....

LOCATION OF WELL: Owner's No. .... CITY AND STATE: .....


..... 1/4 ..... 1/4 Sec. .... T. .... N. S., R. .... E. W., W.M.

Bearing and distance from section or subdivision corner .....

Altitude at well *4.066* .....

TYPE OF WELL: *Drilled* Date Constructed .....

Depth drilled *327* ..... Depth cased .....

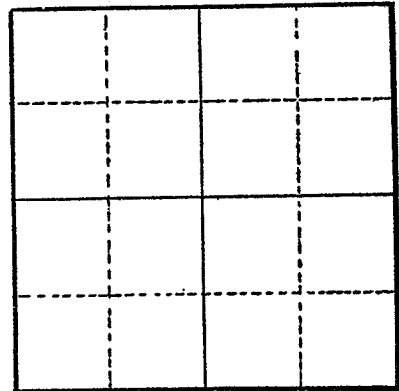

Section .....

CASING RECORD:  
*10-8 inch*

FINISH:

AQUIFERS:  
*Sand and gravel (?)*

WATER LEVEL:  
*21 feet below land surface, 1943*

PUMPING EQUIPMENT: Type *Turbine* ..... H.P. ....  
Capacity *600* ..... G.P.M. ....

WELL TESTS:  
Drawdown ..... ft. after ..... hours ..... G.P.M.  
Drawdown ..... ft. after ..... hours ..... G.P.M.

USE OF WATER *Public Supply* ..... Temp. .... °F. ...., 19....

SOURCE OF INFORMATION *USGS* .....

DRILLER or DIGGER .....

ADDITIONAL DATA:  
Log ..... Water Level Measurements ..... Chemical Analysis ..... Aquifer Test .....

REMARKS:  
*City Well No. 2; located 300 ft. west of well No. 1; drawdown 10 ft. when pumped at 532 gpm for 1 hr.*