

STATE ENGINEER
Salem, Oregon


12UAM
18096

Well Record

STATE WELL NO. 41/12-15M
COUNTY Klamath
APPLICATION NO. 6-1167

OWNER: Malin Municipal Water System (City of Malin)
LOCATION OF WELL: Owner's No. #2
MAILING ADDRESS: Malin, Oregon
CITY AND STATE: Malin, Oregon

NW 1/4 SW 1/4 Sec. 15 T. 41 S. R. 12 E. W.M.
Bearing and distance from section or subdivision
corner 73°25' E. 501' 7" from 1/4 cor. of
sections 15 & 16.

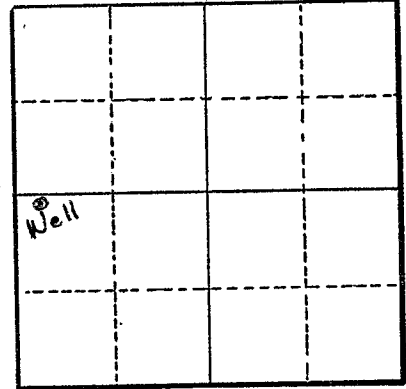

Section 15

Altitude at well 4200 ft.

TYPE OF WELL: Drilled Date Constructed 1937
Depth drilled 380 ft. Depth cased 100 ft.

CASING RECORD:
10 inch standardpipe 0 to 100 ft.

FINISH:

AQUIFERS:

WATER LEVEL:
21 ft.

PUMPING EQUIPMENT: Type Layne pump H.P. 25
Capacity 600 G.P.M.

WELL TESTS:
Drawdown 10 ft. after 532 1/2 hours G.P.M.
Drawdown 9 ft. after 450 hours G.P.M.

USE OF WATER Municipal Temp. °F. 19
SOURCE OF INFORMATION Related registration statement
DRILLER or DIGGER
ADDITIONAL DATA:

Log Water Level Measurements Chemical Analysis Aquifer Test

REMARKS:

Log: Soil 0 to 5 ft.
Rocks with sand & clay layers 5 to 100 ft.
Lava rock & stratas of Honeycomb
lava rock 100 to 370 ft.
Heavy black water sand 370 to 380 ft.