

STATE ENGINEER
Salem, Oregon

KLAM
15 98

Well Record

STATE WELL NO. 35/11-30K1
COUNTY Klamath
APPLICATION NO.

OWNER: L. G. Griffith

MAILING
ADDRESS:


LOCATION OF WELL: Owner's No.

CITY AND
STATE:

..... 1/4 1/4 Sec. T. N. E.
..... S., R. W., W.M.

Bearing and distance from section or subdivision

corner

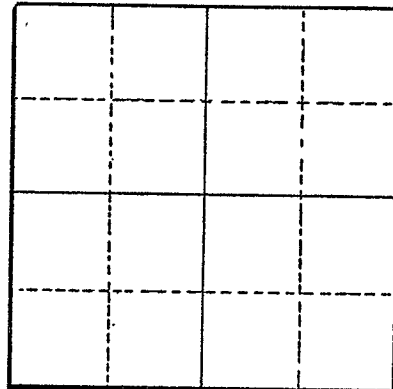

Section

Altitude at well 4,400

TYPE OF WELL: Drilled Date Constructed

Depth drilled 987 Depth cased

CASING RECORD:

6 inch

FINISH:

AQUIFERS:

WATER LEVEL:

18 feet below land surface in 1953

PUMPING EQUIPMENT: Type None

Capacity G.P.M.

H.P.

WELL TESTS:

Drawdown ft. after hours G.P.M.

Drawdown ft. after hours G.P.M.

USE OF WATER Temp. °F., 19

SOURCE OF INFORMATION USGS

DRILLER or DIGGER

ADDITIONAL DATA:

Log Water Level Measurements Chemical Analysis Aquifer Test

REMARKS:

Very little water; mostly chalk rock for entire depth.