

KLAM 1897

STATE ENGINEER
Salem, Oregon

KLAM
1897 Well Record

STATE WELL NO. 36/10-13F1
COUNTY Klamath
APPLICATION NO.

OWNER: Ivy C. Clark MAILING ADDRESS:

LOCATION OF WELL: Owner's No. CITY AND STATE:


..... 1/4 1/4 Sec. T. N. E.
..... S., R. W., W.M.

Bearing and distance from section or subdivision
corner

Altitude at well 4,320

TYPE OF WELL: Drilled Date Constructed

Depth drilled 400 Depth cased 42

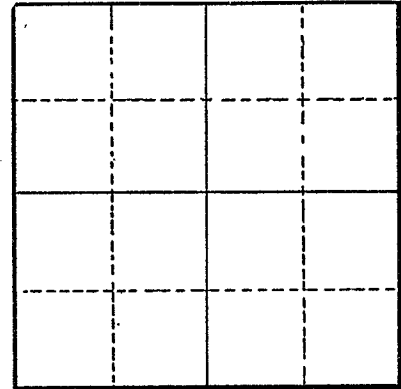

Section

CASING RECORD:

12 inch

FINISH:

AQUIFERS:

Sand, black from 320 to 400

WATER LEVEL:

Flowing well--8/5/54

PUMPING EQUIPMENT: Type None H.P.

Capacity G.P.M.

WELL TESTS:

Drawdown ft. after hours G.P.M.

Drawdown ft. after hours G.P.M.

USE OF WATER Irrigation Temp. °F., 19

SOURCE OF INFORMATION USGS

DRILLER or DIGGER

ADDITIONAL DATA:

Log Water Level Measurements Chemical Analysis Aquifer Test

REMARKS:

Reportedly flows 400 gpm and is used to irrigate 25 to 30 acres; penetrated chalk rock to 380 ft.

Calcium carbonate 30 p.p.m.

Chloride 4 p.p.m.



Oregon Water Resources Department
 725 Summer Street NE, Suite A
 Salem Oregon 97301
 (503) 986-0900
 www.oregon.gov/owrd

Application for Well ID Number

RECEIVED

APR 05 2021

OWRD

Do not complete if the well already has a Well Identification Number.

I. OWNER INFORMATION

Current Owner Name (please print): Juanita Ann Haskins
 Mailing Address: 25660 Sprague River Rd.
 City, State, Zip: Sprague River, OR. 97639
 Mail Well ID to: SAME AS ABOVE In Care Of (C/O)
 Name & Address: _____
 City, State, Zip: _____

II. WELL LOCATION INFORMATION (Please fill out as completely as possible)

Township: 36S (North / South) Range: 10E (East / West) Section: 13 SE 1/4 of the NW 1/4
 Tax Lot (usually last 3-5 numbers of Tax Map #): 1200 County KLAMATH
 GPS Coordinates: _____
 Street Address of Well, City: 25660 Sprague River Rd. Sprague River
 If the property had a different street address in the past: _____

III. GENERAL WELL INFORMATION (Please fill out as completely as possible, AND attach copy of Well Report, if available)

Use of Well (domestic, irrigation, commercial, industrial, monitoring): domestic, irrigation
 Date Well Constructed (or property built): _____ Total Well Depth: 42' Casing Diameter: 12"
 Owner at time the well was constructed (if known): Ivey Clark Well Report # (if known): KLAM 1897
 Other Information: water right certificate 84647

SUBMITTED BY (please print): Danny Allen
 PHONE: 541-892-0652 EMAIL &/or FAX: frontierda@aol.com

Send application to: Oregon Water Resources Department 725 Summer St. NE, Suite A, Salem, Oregon 97301, fax to (503) 986-0902, or you are welcome to email the completed form to Ladeena.K.Ashley@oregon.gov.

For Official Use Only by the Oregon Water Resources Department:

Received Date:

4-5-21

Well Report Number:

KLAM 1897

Well Identification #:

L 142414