

STATE ENGINEER
Salem, Oregon

KLAMATH
1906 OBSERVATION WELL
Well Record

STATE WELL NO. 36/10-14G(1)
COUNTY Klamath
APPLICATION NO. U-536
(Canceled)

CLIFFORD EMMICH

OWNER: ~~K. R. Newton~~


MAILING ADDRESS: Box 23

LOCATION OF WELL: Owner's No. _____

CITY AND STATE: Sprague River, Oregon

SW 1/4 NE 1/4 Sec. 14 T. 36 N. S. R. 10 W., W.M.

Bearing and distance from section or subdivision corner _____

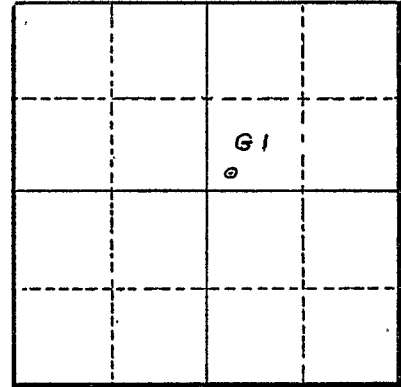

Section 14

Altitude at well _____

TYPE OF WELL: Drilled Date Constructed 1953

Depth drilled 527 Depth cased _____

CASING RECORD:

14 inch

FINISH:

AQUIFERS:

Lava

WATER LEVEL:

16' aug. 1953

PUMPING EQUIPMENT: Type None H.P. _____
Capacity _____ G.P.M.

WELL TESTS: Drawdown 81 ft. after 7 hours 1350 G.P.M.
Drawdown 78 ft. after 7 hours 1300 G.P.M.
Drawdown 61 ft. after 1/2 hours 1050 G.P.M.

USE OF WATER None Stock Temp. _____ °F. _____, 19____

SOURCE OF INFORMATION Driller report U-538

DRILLER or DIGGER W. L. Hartley & Son

ADDITIONAL DATA:

Log Water Level Measurements Chemical Analysis _____ Aquifer Test _____

REMARKS:

