

STATE ENGINEER
Salem, Oregon

*KLAM
1945*

Well Record

STATE WELL NO. 36/11-8P(1)
COUNTY Klamath
APPLICATION NO. U-240

OWNER: Frank Goularte

MAILING
ADDRESS:


LOCATION OF WELL: Owner's No. 4

CITY AND
STATE:

Canby, Calif.

SE^{1/4} SW^{1/4} Sec. 8 T. 36 N.
S., R. 11 E. W.M.

Bearing and distance from section or subdivision
corner

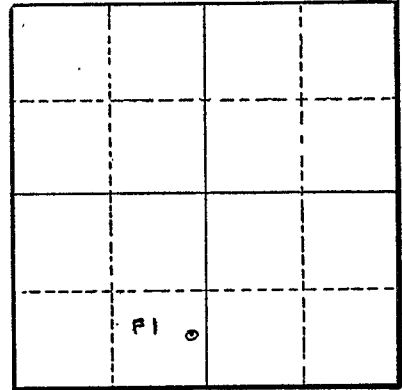

Section 8

Altitude at well 4305 (USGS Report)

TYPE OF WELL: Drilled Date Constructed 1947

Depth drilled 523 Depth cased 470

CASING RECORD:

12 inch set to 470 feet

FINISH:

open hole

AQUIFERS:

WATER LEVEL:

+32.75 feet on 2-16-55

PUMPING EQUIPMENT: Type None H.P. _____
Capacity _____ G.P.M.

WELL TESTS:

Drawdown _____ ft. after _____ hours _____ G.P.M.
Drawdown _____ ft. after _____ hours _____ G.P.M.

USE OF WATER Irrigation Temp. _____ °F., 19_____

SOURCE OF INFORMATION U-240 USGS Report

DRILLER or DIGGER _____

ADDITIONAL DATA:

Log Water Level Measurements Chemical Analysis _____ Aquifer Test _____

REMARKS:

USGS Observation Well

STATE ENGINEER
Salem, Oregon

State Well No. 36/11 - 8P(1)

County Klamath

Application No. U 240

Water Level Record

OWNER: Frank Goularte OWNER'S NO. 4

Description of measuring point: Pressure gage at LSD

Date	Water Level Feet (above) (below) Land Surface	Remarks	Date	Water Level Feet (above) (below) Land Surface	Remarks
4-8-56	31				

REMARKS: _____

