

STATE ENGINEER
Salem, Oregon

KLAM
1965 Well Record

STATE WELL NO. 36/11 - 15L(1)
COUNTY Klamath
APPLICATION NO. U-585

OWNER: Frank & Virginia Goularte


MAILING ADDRESS: Canby, California

LOCATION OF WELL: Owner's No. 6
Lot 22

CITY AND STATE: Canby, California

NE 1/4 SW 1/4 Sec. 15 T. 36 ~~N.~~ S., R. 11 ~~E.~~ W., W.M.

Bearing and distance from section or subdivision corner approx. 720 ft. S and 200 ft. W. from center of said Section 15

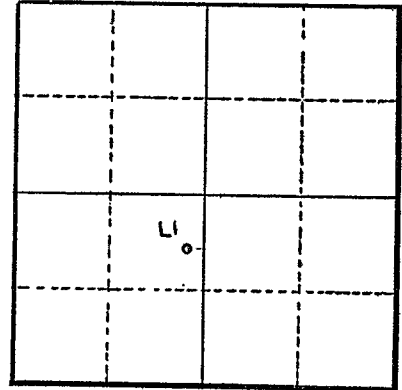

Section 15

Altitude at well _____

TYPE OF WELL: Drilled Date Constructed July 1948

Depth drilled 260 ft. Depth casé 18 feet

CASING RECORD: _____

FINISH: _____

AQUIFERS: _____

WATER LEVEL: _____

20 feet below ground surface

PUMPING EQUIPMENT: Type Johnson H.P. _____
Capacity 2000 G.P.M. _____

WELL TESTS:

Drawdown 6-8 ft. after 12 days hours 2000 G.P.M. _____

Drawdown _____ ft. after _____ hours _____ G.P.M. _____

USE OF WATER Irrigation Temp. _____ °F. _____, 19_____

SOURCE OF INFORMATION _____

DRILLER or DIGGER W. L. Hartley & Son, Bonanza, Oregon

ADDITIONAL DATA:

Log Water Level Measurements _____ Chemical Analysis _____ Aquifer Test _____

REMARKS: _____

