

OWNER: Frank Goularta

MAILING ADDRESS:


Canby, Calif.

LOCATION OF WELL: Owner's No. 3

CITY AND STATE:

SW $\frac{1}{4}$ NW $\frac{1}{4}$ Sec. 16 T. 36 N. S., R. 11 E. W., W.M.

Bearing and distance from section or subdivision corner

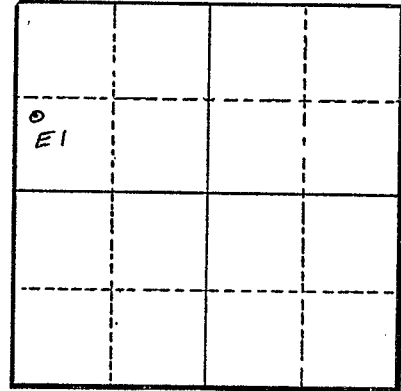

Section 16

Altitude at well

TYPE OF WELL: Drilled Date Constructed 1947

Depth drilled 350 Depth cased

CASING RECORD:

8 inch

FINISH:

AQUIFERS:

WATER LEVEL:

PUMPING EQUIPMENT: Type _____ H.P. _____
Capacity _____ G.P.M.

WELL TESTS:

Drawdown _____ ft. after _____ hours _____ G.P.M.
Drawdown _____ ft. after _____ hours _____ G.P.M.

USE OF WATER Irrigation Temp. _____ °F. _____, 19____

SOURCE OF INFORMATION U-240

DRILLER or DIGGER _____

ADDITIONAL DATA:

Log Water Level Measurements _____ Chemical Analysis _____ Aquifer Test _____

REMARKS:

Flowing well

