

STATE ENGINEER
Salem, Oregon

KLAM
~~1973~~ Well Record

STATE WELL NO. 36/11-16N(1)
COUNTY Klamath
APPLICATION NO. U-240

OWNER: Frank Goularte MAILING ADDRESS: Canby, Calif.

LOCATION OF WELL: Owner's No. 2 CITY AND STATE:


SW 1/4 SW 1/4 Sec. 16 T. 36 N. S. R. 11 E. W., W.M.

Bearing and distance from section or subdivision corner

Altitude at well

TYPE OF WELL: Drilled Date Constructed 1944

Depth drilled 313 Depth cased

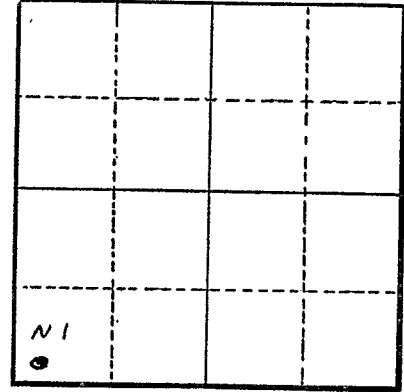

Section 16

CASING RECORD:

12 inch

FINISH:

AQUIFERS:

WATER LEVEL:

PUMPING EQUIPMENT: Type Capacity G.P.M. H.P.

WELL TESTS: Drawdown ft. after hours G.P.M. Drawdown ft. after hours G.P.M.

USE OF WATER Irrigation Temp. °F. 19

SOURCE OF INFORMATION U-240 USGS Report

DRILLER or DIGGER

ADDITIONAL DATA:

Log Water Level Measurements Chemical Analysis Aquifer Test

REMARKS:

Deepened from 235 to 313' in 1948

