

STATE ENGINEER  
Salem, Oregon

KLAM  
1974

# Well Record

STATE WELL NO. 36/11-16P(1)  
COUNTY Klamath  
APPLICATION NO. U-240

OWNER: Frank Goularte


MAILING ADDRESS: Canby, California

LOCATION OF WELL: Owner's No. 1

CITY AND STATE:

SE 1/4 SW 1/4 Sec. 16 T. 36 N. S., R. 11 W., W.M.

Bearing and distance from section or subdivision corner

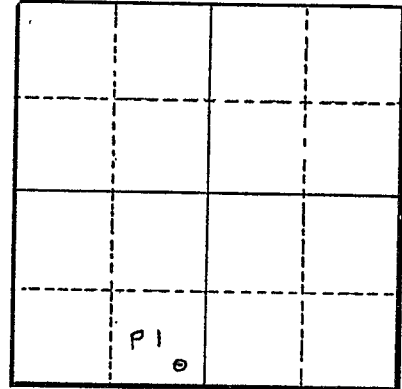

Section 16

Altitude at well 4350 (USGS Report)

TYPE OF WELL: Drilled Date Constructed 1944

Depth drilled 225 Depth cased

### CASING RECORD:

12 inch

### FINISH:

### AQUIFERS:

### WATER LEVEL:

PUMPING EQUIPMENT: Type None H.P.  
Capacity G.P.M.

WELL TESTS:  
Drawdown ft. after hours G.P.M.  
Drawdown ft. after hours G.P.M.

USE OF WATER Irrigation Temp. °F., 19  
SOURCE OF INFORMATION U-240 USGS Report

DRILLER or DIGGER

### ADDITIONAL DATA:

Log  Water Level Measurements  Chemical Analysis  Aquifer Test

### REMARKS:

Flowing well

