

STATE ENGINEER  
Salem, Oregon

*KLAMATH* OBSERVATION WELL  
~~1976~~ Well Record  
1976


STATE WELL NO. 36/11-17Q(1)  
COUNTY Klamath  
APPLICATION NO. U-485

OWNER: Oscar H. Capellen (*ERNEST FIRSICK*) MAILING ADDRESS: .....

LOCATION OF WELL: Owner's No. 2 CITY AND STATE: Sprague River, Oregon

SW 1/4 SE 1/4 Sec. 17 T. 36 S., R. 11 E., W.M.

Bearing and distance from section or subdivision corner .....

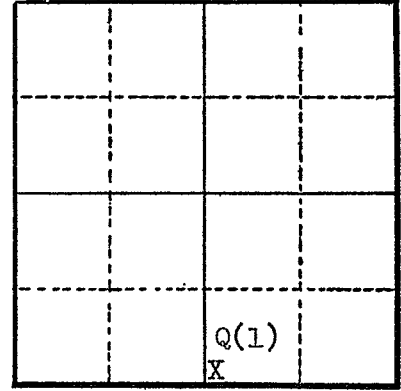

Section 17

Altitude at well .....

TYPE OF WELL: Drilled Date Constructed 1947

Depth drilled 446 Depth cased 40 ft.

CASING RECORD: 12 inch

FINISH:

AQUIFERS:

*U.S.G.S. STATES POROUS ZONES IN BASALT FROM 400' TO 468'*

WATER LEVEL:

*2.98 BELOW L.S.D. (4-14-53)*

PUMPING EQUIPMENT: Type turbine H.P. ....  
Capacity 1600 G.P.M.

WELL TESTS:

Drawdown ..... ft. after ..... hours ..... G.P.M.  
Drawdown ..... ft. after ..... hours ..... G.P.M.

USE OF WATER Irrigation Temp. °F. ...., 19....

SOURCE OF INFORMATION U-485

DRILLER or DIGGER W. L. Hartley & Son, Bonanza, Oregon

ADDITIONAL DATA:

Log ..... Water Level Measurements ..... Chemical Analysis ..... Aquifer Test .....

REMARKS: Assigned to: Ernest & Gloria Firsick

*PUMPED DRAWDOWN 8' AT 1500 GPM.*

