

STATE ENGINEER  
Salem, Oregon

*KLAM*  
*1977* Well Record

STATE WELL NO. 36/11-17R(1)  
COUNTY Klamath  
APPLICATION NO. U-485

OWNER: Oscar H. Capellen MAILING ADDRESS: \_\_\_\_\_

LOCATION OF WELL: Owner's No. 1 CITY AND STATE: Sprague River, Oregon


SE 1/4 SE 1/4 Sec. 17 T. 36 S., R. 11 E. W.M.

Bearing and distance from section or subdivision corner \_\_\_\_\_

Altitude at well \_\_\_\_\_

TYPE OF WELL: Drilled Date Constructed 1948

Depth drilled 330 Depth cased 100

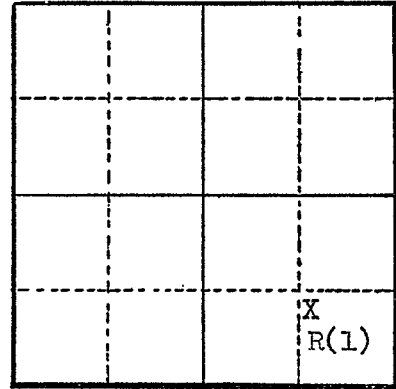

Section 17

CASING RECORD: 12 in. casing to 100 ft.

FINISH: \_\_\_\_\_

AQUIFERS: U.S.G.S. STATES BASALT FROM 280' TO 330'

WATER LEVEL: Artesian flow

PUMPING EQUIPMENT: Type \_\_\_\_\_ H.P. \_\_\_\_\_  
Capacity \_\_\_\_\_ G.P.M.

WELL TESTS:  
Drawdown \_\_\_\_\_ ft. after \_\_\_\_\_ hours \_\_\_\_\_ G.P.M.  
Drawdown \_\_\_\_\_ ft. after \_\_\_\_\_ hours \_\_\_\_\_ G.P.M.

USE OF WATER Irrigation Temp. \_\_\_\_\_ °F., 19\_\_\_\_

SOURCE OF INFORMATION U-485

DRILLER or DIGGER W. L. Hartley & Son, Bonanza, Oregon

ADDITIONAL DATA:  
Log \_\_\_\_\_ Water Level Measurements \_\_\_\_\_ Chemical Analysis \_\_\_\_\_ Aquifer Test \_\_\_\_\_

REMARKS: Assigned to Ernest & Gloria Firsick

*FLOWED ABOUT 1,350 GPM; PENETRATED 280' OF CHALK ROCK ABOVE AQUIFER.*

