

STATE ENGINEER
Salem, Oregon

KLAM
1980 Well Record

STATE WELL NO. 36/11-18H(1)
COUNTY Klamath
APPLICATION NO. U-244

OWNER: D. M. Hess


MAILING ADDRESS: _____

LOCATION OF WELL: Owner's No. _____

CITY AND STATE: _____

SE $\frac{1}{4}$ NE $\frac{1}{4}$ Sec. 18 T. 36 ^{N.} S., R. 11 ^{E.} W., W.M.

Bearing and distance from section or subdivision corner _____

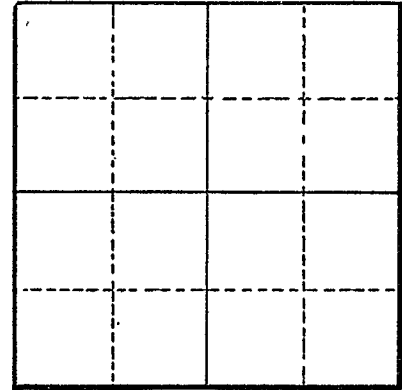

Section 18

Altitude at well 4335

TYPE OF WELL: Drilled Date Constructed _____

Depth drilled 625 Depth cased 100

CASING RECORD:

12 inch

FINISH:

AQUIFERS:

Basalt, 568 to 625 feet

WATER LEVEL:

Flows

PUMPING EQUIPMENT: Type None H.P. _____
Capacity _____ G.P.M.

WELL TESTS:

Drawdown _____ ft. after _____ hours _____ G.P.M.

Drawdown _____ ft. after _____ hours _____ G.P.M.

USE OF WATER Irrigation Temp. 72 °F., 19 _____

SOURCE OF INFORMATION _____

DRILLER or DIGGER _____

ADDITIONAL DATA:

Log _____ Water Level Measurements _____ Chemical Analysis _____ Aquifer Test _____

REMARKS:

568 feet of chalk and clay above aquifer