

WATER WELL REPORT
STATE OF OREGON

KLAM 2159

See Note in 12 Below

RECEIVED
JUL 10 1981

State Well No. *365/4E-3100*

WATER RESOURCES DEPT
SALEM, OREGON

Permit No. *Reamed*

(1) OWNER:
Name *Wayne Smith*
Address *PO Box 46*
City *Bly, Oregon* State *97622*

(2) TYPE OF WORK (check): *Reamed*
New Well Deepening Reconditioning Abandon
If abandonment, describe material and procedure in Item 12.

(3) TYPE OF WELL: Rotary Air Driven Rotary Mud Dug Cased Bored

(4) PROPOSED USE (check): Domestic Industrial Municipal Irrigation Test Well Other Thermal Withdrawal ReInjection

(5) CASING INSTALLED: Steel Plastic Threaded Welded
"Diam. from _____ ft. to _____ ft. Gauge _____
"Diam. from _____ ft. to _____ ft. Gauge _____

LINER INSTALLED:
"Diam. from _____ ft. to _____ ft. Gauge _____

(6) PERFORATIONS: Perforated? Yes No
Type of perforator used _____
Size of perforations _____ in. by _____ in.
_____ perforations from _____ ft. to _____ ft.
_____ perforations from _____ ft. to _____ ft.
_____ perforations from _____ ft. to _____ ft.

(7) SCREENS: Well screen installed? Yes No
Manufacturer's Name _____ Type _____ Model No. _____
Diam. _____ Slot Size _____ Set from _____ ft. to _____ ft.
Diam. _____ Slot Size _____ Set from _____ ft. to _____ ft.

(8) WELL TESTS: Drawdown is amount water level is lowered below static level
Was a pump test made? Yes No If yes, by whom? _____
_____ gal./min. with _____ ft. drawdown after _____ hrs.
Air test _____ gal./min. with drill stem at _____ ft. _____ hrs.
Bailer test _____ gal./min. with _____ ft. drawdown after _____ hrs.
Artesian flow _____ g.p.m.
Temperature of water _____ Depth artesian flow encountered _____ ft.

(9) CONSTRUCTION: Special standards: Yes No
Well seal—Material used *Undisturbed*
Well sealed from land surface to _____ ft.
Diameter of well bore to bottom of seal _____ in.
Diameter of well bore below seal _____ in.
Number of sacks of cement used in well seal _____ sacks
How was cement grout placed? _____
Was pump installed? _____ Type _____ HP _____ Depth _____ ft.
Was a drive shoe used? Yes No Plug _____ Size: location _____ ft.
Did any strata contain unusable water? Yes No
Type of Water? _____ depth of strata _____
Method of sealing strata off _____
Was well gravel packed? Yes No Size of gravel: _____
Gravel placed from _____ ft. to _____ ft.

(10) LOCATION OF WELL:
County *Klamath* Driller's well number _____
SW $\frac{1}{4}$ NE $\frac{1}{4}$ Section *31* T. *36S* R. *14E* W.M.
Tax Lot # _____ Lot _____ Blk _____ Subdivision _____
Address at well location: *Bly*

(11) WATER LEVEL: Completed well.
Depth at which water was first found _____ ft.
Static level *124* ft. below land surface. Date _____
Artesian pressure _____ lbs. per square inch. Date _____

(12) WELL LOG: Diameter of well below casing *10"*
Depth drilled _____ ft. Depth of completed well _____ ft.
Formation: Describe color, texture, grain size and structure of materials; and show thickness and nature of each stratum and aquifer penetrated, with at least one entry for each change of formation. Report each change in position of Static Water Level and indicate principal water-bearing strata.

MATERIAL	From	To	SWL
<i>Reamed Out to 10" For Pump, From 106' to 201'</i>			
<i>Lower Rock</i>	<i>106</i>	<i>201</i>	<i>124'</i>
<i>Depth of Well—Cleaned out to 324' with 8" Bit</i>			
<i>Amended</i>			
<i>Legal is - NE 1/4 of SE 1/4 of Sec. 30 T. 36S. R. 14E</i>			
<i>Reginald Chancellor</i>			

RECEIVED

MAY 2 2005

WATER RESOURCES DEPT
SALEM, OREGON

Work started *6-10* 19 *81* Completed *6-12* 19 *81*
Date well drilling machine moved off of well *6-12* 19 *81*

Drilling Machine Operator's Certification:
This well was constructed under my direct supervision. Materials used and information reported above are true to my best knowledge and belief.
[Signed] *Reginald Chancellor* Date *7-8*, 19*81*
(Drilling Machine Operator)
Drilling Machine Operator's License No. *1064*

Water Well Contractor's Certification:
This well was drilled under my jurisdiction and this report is true to the best of my knowledge and belief.
Name *Reginald Chancellor Well-Drilling*
(Person, firm or corporation) (Type or print)
Address *5233 Valley View Lane K. Falls Ore.*
[Signed] *Reginald Chancellor*
(Water Well Contractor)
Contractor's License No. *693* Date *7-8*, 19*81*

NOTICE TO WATER WELL CONTRACTOR
The original and first copy of this report are to be filed with the

WATER RESOURCES DEPARTMENT,
SALEM, OREGON 97310
within 30 days from the date of well completion.

SP-12658-690

**WATER WELL REPORT
STATE OF OREGON**

*KLAMATH
9/15/91
c*

RECEIVED

JUL 10 1981

State Well No. *365/4E-31aC*

WATER RESOURCES DEPT
SALEM, OREGON

State Permit No.
Reamed

(1) OWNER:

Name *Wayne Smith*
Address *PO Box 46*
City *Bly, Oregon* State *97622*

(2) TYPE OF WORK (check): **Reamed**

New Well Deepening Reconditioning Abandon

If abandonment, describe material and procedure in Item 12.

(3) TYPE OF WELL: (4) PROPOSED USE (check):

Rotary Air Driven Domestic Industrial Municipal
Rotary Mud Dug Irrigation Test Well Other
Cable Bored Thermal: Withdrawal Reinjection

(5) CASING INSTALLED:

Steel Plastic
Threaded Welded
" Diam. from ... ft. to ... ft. Gauge
" Diam. from ... ft. to ... ft. Gauge

(6) LINER INSTALLED:

" Diam. from ... ft. to ... ft. Gauge

(7) PERFORATIONS:

Perforated? Yes No
Type of perforator used
Size of perforations in by in.
perforations from ... ft. to ... ft.
perforations from ... ft. to ... ft.
perforations from ... ft. to ... ft.

(8) SCREENS:

Well screen installed? Yes No
Manufacturer's Name
Type Model No.
Diam. Slot Size Set from ... ft. to ... ft.
Diam. Slot Size Set from ... ft. to ... ft.

(9) WELL TESTS:

Drawdown is amount water level is lowered below static level
Was a pump test made? Yes No If yes, by whom?
gal./min. with ft. drawdown after hrs.
Air test gal./min. with drill stem at ft. hrs.
Bailer test gal./min. with ft. drawdown after hrs.
Artesian flow g.p.m.
Temperature of water Depth artesian flow encountered ... ft.

(10) CONSTRUCTION:

Special standards: Yes No
Well seal—Material used *Undisturbed*
Well sealed from land surface to ... ft.
Diameter of well bore to bottom of seal ... in.
Diameter of well bore below seal ... in.
Number of sacks of cement used in well seal ... sacks
How was cement grout placed?
Was pump installed? Type HP Depth ft.
Was a drive shoe used? Yes No Flugs Size: location ft.
Did any strata contain unusable water? Yes No
Type of Water? depth of strata
Method of sealing strata off
Was well gravel packed? Yes No Size of gravel: ft.
Gravel placed from ... ft. to ... ft.

(10) LOCATION OF WELL:

County *Klamath* Driller's well number
SW 1/4 NE 1/4 Section 31 T. 36S R. 14E W.M.
Tax Lot # Lot Blk Subdivision
Address at well location: *Bly*

(11) WATER LEVEL: Completed well.

Depth at which water was first found ... ft.
Static level *124* ft. below land surface. Date
Artesian pressure lbs. per square inch. Date

(12) WELL LOG:

Diameter of well below casing *10"*
Depth drilled ... ft. Depth of completed well ... ft.

Formation: Describe color, texture, grain size and structure of materials; and show thickness and nature of each stratum and aquifer penetrated, with at least one entry for each change of formation. Report each change in position of Static Water Level and indicate principal water-bearing strata.

MATERIAL	From	To	SWL
<i>Reamed Out to 10" For Pump, From 106' to 201'</i>			
<i>Lower Rock</i>	<i>106</i>	<i>201</i>	<i>124'</i>
<i>Depth of Well-Cleaned out to 324' With 8" Bit.</i>			

Work started *6-10* 19 *81* Completed *6-12* 19 *81*
Date well drilling machine moved off of well *6-12* 19 *81*

Drilling Machine Operator's Certification:

This well was constructed under my direct supervision. Materials used and information reported above are true to my best knowledge and belief.
[Signed] *Allyn W. Chancellor* Date *7-8*, 19 *81*
(Drilling Machine Operator)
Drilling Machine Operator's License No. *1064*

Water Well Contractor's Certification:

This well was drilled under my jurisdiction and this report is true to the best of my knowledge and belief.
Name *Allyn W. Chancellor Well-Drilling*
(Person, firm or corporation) (Type or print)
Address *5233 Valley View Lane K. Falls Ore.*
[Signed] *Allyn W. Chancellor*
(Water Well Contractor)
Contractor's License No. *693* Date *7-8*, 19 *81*

NOTICE TO WATER WELL CONTRACTOR

The original and first copy of this report are to be filed with the


WATER RESOURCES DEPARTMENT,
SALEM, OREGON 97310
within 30 days from the date of well completion.

RECEIVED
MAY 12 2005
WATER RESOURCES DEPT
SALEM, OREGON

THIS MAP WAS PREPARED FOR
ASSESSMENT PURPOSE ONLY.

SECTION 30 T.36S. R.14E. WM.
KLAMATH COUNTY
1-4-03

36 14 30
& INDEX

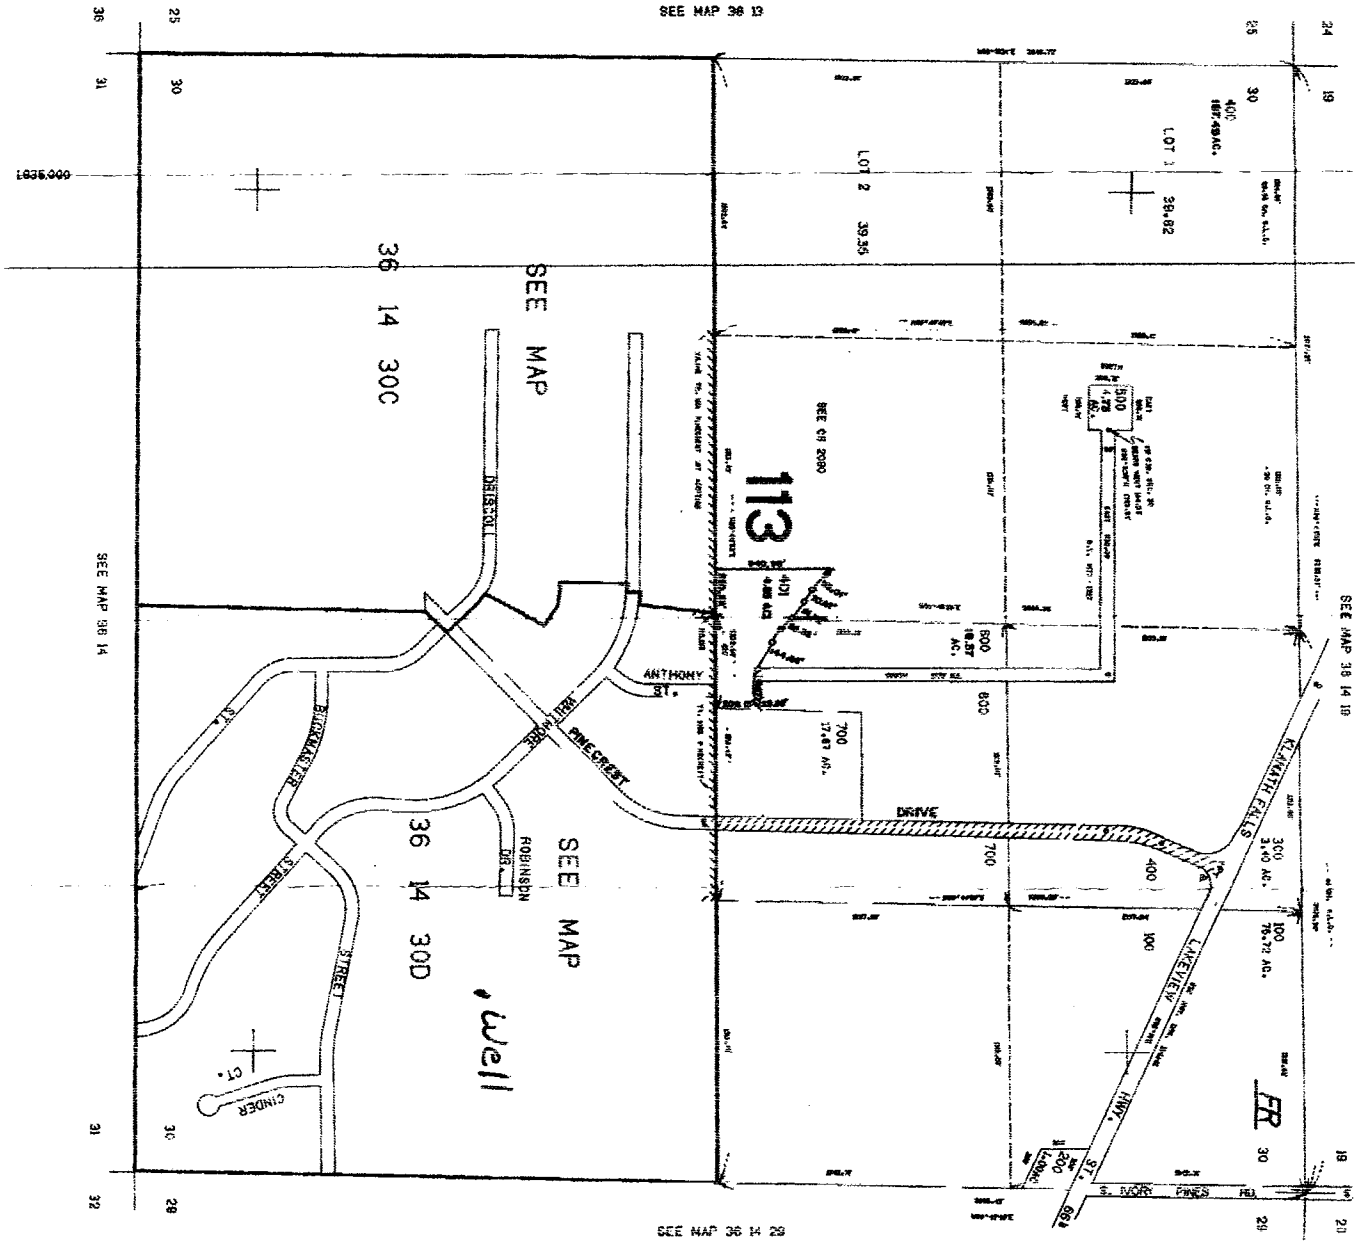

SEE MAP 36 13

SEE MAP 36 14 18

SEE MAP 36 14 29

CANCELLED
NO. 82

273.000

36 14 30
& INDEX