

KLAM 2168

OBSERVATION WELL

STATE ENGINEER
Salem, Oregon

Well Record

STATE WELL NO. 36/14-35R(1)
COUNTY KLAMATH
APPLICATION NO. _____

G-1673

OWNER: BASIL HALL MAILING ADDRESS: BLT

LOCATION OF WELL: Owner's No. _____ CITY AND STATE: _____


SE 1/4 SE 1/4 Sec. 35 T. 36 ^{N.} S., R. 14 ^{E.} W., W.M.

Bearing and distance from section or subdivision corner _____

Altitude at well _____

TYPE OF WELL: DRILLED Date Constructed 6-5-60

Depth drilled 400 Depth cased 60'

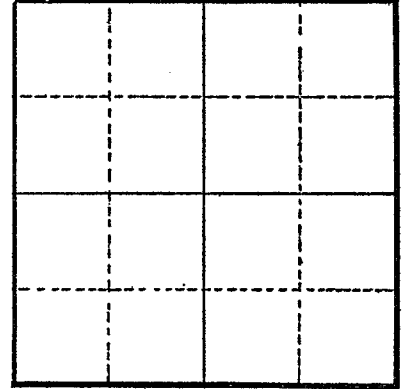

Section 35

CASING RECORD:

18"

FINISH:

AQUIFERS:

LAVA

WATER LEVEL:

13.96 (4-3-62)

PUMPING EQUIPMENT: Type _____ H.P. _____
Capacity _____ G.P.M.

WELL TESTS:

Drawdown _____ ft. after _____ hours _____ G.P.M.

Drawdown _____ ft. after _____ hours _____ G.P.M.

USE OF WATER IRRIGATION Temp. _____ °F. _____, 19____

SOURCE OF INFORMATION DRILLER

DRILLER or DIGGER HATCH DRILLING CO.

ADDITIONAL DATA:

Log Water Level Measurements Chemical Analysis _____ Aquifer Test _____

REMARKS:

36/4-35R(1)
Klamath
HARVEY R. HATCH

HATCH DRILLING COMPANY
LICENSED DRILLING CONTRACTORS

DAVID W. SWAIN

P. O. BOX 473, HALF MOON BAY, CALIF.

6-5-1960

Well Log BASAL HALL

RECEIVED
AUG 4 1960
STATE ENGINEER
SALEM, OREGON

0-2 Topsoil

2-24 BLACK PUMICE

24-35 yellow LAVA and clay

35-60 BLACK LAVA and clay

60-167 BLACK LAVA Boulders Hard

167-227 BLACK LAVA and clay streaks

227-303 Water Bearing, LAVA GRAVEL

303-400 HARD BLACK LAVA and clay STREAKS

Hatch Drilling Co.

Licence # 284

By *Harvey R. Hatch*

W.L. 13'
Casing 18" set to 60' *gd*