

STATE ENGINEER
Salem, Oregon

KLAMATH
2256 Well Record


STATE WELL NO. 37/9-36H(2).
COUNTY Klamath
APPLICATION NO. U-457

OWNER: John A. & William F. Marshall MAILING ADDRESS: Route 2, Box 808

LOCATION OF WELL: Owner's No. CITY AND STATE: Klamath Falls, Oregon

SW 1/4 NW 1/4 Sec. 36 T. 37 N. S., R. 9 E. W., W.M.

Bearing and distance from section or subdivision corner N 23° W 452' from E 1/4 cor. Sec. 36

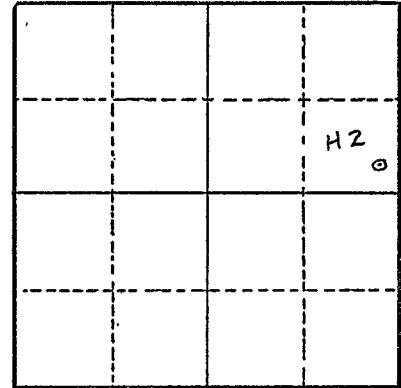

Section 36

Altitude at well

TYPE OF WELL: Drilled Date Constructed

Depth drilled 1800 Depth cased 600

CASING RECORD:

16 inch
12 inch
casing set to 600 feet

FINISH:

AQUIFERS:

WATER LEVEL:

51 September 53

PUMPING EQUIPMENT: Type H.P.
Capacity G.P.M.

WELL TESTS:

Drawdown ft. after hours G.P.M.
Drawdown ft. after hours G.P.M.

USE OF WATER Temp. °F., 19

SOURCE OF INFORMATION

DRILLER or DIGGER

ADDITIONAL DATA:

Log Water Level Measurements Chemical Analysis Aquifer Test

REMARKS:

Penetrated tertiary sedimentary rocks, obtained only small yield

