

**(1) OWNER:**  
Name Albert R. Devine  

S.W. 1/4 SE 1/4 Section 9 T. 37S R. 10E .W.M.  
Bearing and distance from section or subdivision corner  
N. 54° 50' E 1103.7' from S. quarter  
corner of Sect. 9, T. 37S,  
R. 10E, W.M.

**TYPE OF WORK (check):**  
New Well  Deepening  Reconditioning  Abandon   
If abandonment, describe material and procedure in Item 11.

**PROPOSED USE (check):**  
Residential  Industrial  Municipal  Irrigation  Test Well  Other   
**(5) TYPE OF WELL:**  
Rotary  Driven   
Cable  Jetted   
Dug  Bored

**(6) CASING INSTALLED:**  
16" Diam. from 0 ft. to 19 ft. Gage .....  
....." Diam. from ..... ft. to ..... ft. Gage .....  
....." Diam. from ..... ft. to ..... ft. Gage .....

**(7) PERFORATIONS:**  
Type of perforator used .....  
Perforated?  Yes  No  
**SIZE of perforations** in. by in.  
..... perforations from ..... ft. to ..... ft.  
..... perforations from ..... ft. to ..... ft.  
**SCREENS:**  
Well screen installed  Yes  No  
Manufacturer's Name .....  
Type ..... Model No. ....  
in. Slot size ..... Set from ..... ft. to ..... ft.  
in. Slot size ..... Set from ..... ft. to ..... ft.

**(8) CONSTRUCTION:**  
Was well gravel packed?  Yes  No Size of gravel: .....  
Gravel placed from ..... ft. to ..... ft.  
Was a surface seal provided?  Yes  No To what depth? ..... ft.  
Material used in seal— .....  
Did any strata contain unusable water?  Yes  No  
Type of water? ..... Depth of strata .....  
Method of sealing strata off .....

**(10) WATER LEVELS:**  
Static level 45 ft. below land surface Date 10/15/51  
Artesian pressure ..... lbs. per square inch Date .....

Log Accepted by: .....  
[Signed] ..... Date ....., 19.....  
(Owner)

**(11) WELL TESTS:**  
Drawdown is amount water level is lowered below static level  
Was a pump test made?  Yes  No If yes, by whom? West-Hitchcock Corp - K.F. - Oreg  
Yield: 4750 gal./min. with 4 ft. drawdown after 2 hrs.  
" " " "  
" " " "  
" " " "  
Bailer test gal./min. with ..... ft. drawdown after ..... hrs.  
Artesian flow ..... g.p.m. Date .....  
Temperature of water 60° Was a chemical analysis made?  Yes  No

**(12) WELL LOG:**  
Diameter of well 10 inches.  
Depth drilled 142 ft. Depth of completed well 142 ft.  
Formation: Describe by color, character, size of material and structure, and show thickness of aquifers and the kind and nature of the material in each stratum penetrated, with at least one entry for each change of formation.

MATERIAL	FROM	TO
Top Soil	0	2
Brown sand stone	2	17
Lava Rock	17	128
Water bearing cinders & broken rock	128	142

Work started 19 Completed 1951

**(13) PUMP:**  
Manufacturer's Name .....  
Type: ..... H.P. ....

**Well Driller's Statement:**  
This well was drilled under my jurisdiction and this report is true to the best of my knowledge and belief.

NAME W.L. Hartley & Son  
(Person, firm, or corporation) (Type or print)  
Address Bellaire, Oregon  
Driller's well number .....  
[Signed] .....  
(Well Driller)  
License No. .... Date ....., 19.....

**KLAM 2263**

STATE ENGINEER  
Salem, Oregon

*KLAM 2263*  
**Well Record**

STATE WELL NO. 37/10-~~1622~~ 9 (11)  
COUNTY Klamath  
APPLICATION NO. U.452

OWNER: A.R. Denvincenzi


MAILING ADDRESS: .....

LOCATION OF WELL: Owner's No. # 2

CITY AND STATE: .....

S S  
SW NE 1/4 Sec. 16 T. 37 S., R. 10 E., W.M.

Bearing and distance from section or subdivision corner .....

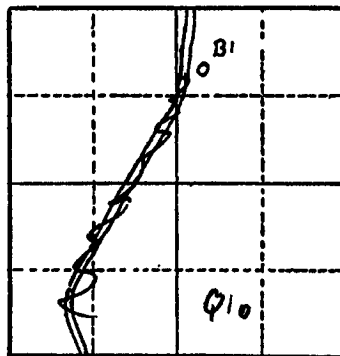

Section no 9

Altitude at well 4,213

TYPE OF WELL: Drilled Date Constructed .....

Depth drilled 142 Depth cased .....

CASING RECORD: 18 inches

FINISH: .....

AQUIFERS: Lava breccia from 111 to 123.5

WATER LEVEL: 45.66 feet below land surface, Sept. 4, 1952

PUMPING EQUIPMENT: Type ~~Blower~~ H.P. ....  
Capacity ..... G.P.M.

WELL TESTS:  
Drawdown ..... ft. after ..... hours ..... G.P.M.  
Drawdown ..... ft. after ..... hours ..... G.P.M.

USE OF WATER Irrigation Temp. .... °F. ...., 19....

SOURCE OF INFORMATION USGS

DRILLER or DIGGER .....

ADDITIONAL DATA:  
Log ..... Water Level Measurements ..... Chemical Analysis ..... Aquifer Test .....

REMARKS: Reportedly yields 4,200 gpm with less than 1 foot drawdown

*Listed as 16811 in USGS Report*

KLAM 2263

STATE ENGINEER  
Salem, Oregon

*KLAM 2263* Well Record

STATE WELL NO. 37/10-16B(1)  
COUNTY Klamath  
APPLICATION NO.

OWNER: A. R. Devincenzi MAILING ADDRESS:

LOCATION OF WELL: Owner's No. CITY AND STATE:


1/4 1/4 Sec. T. N. E. S, R. W., W.M.

Bearing and distance from section or subdivision corner

Altitude at well 4,213

TYPE OF WELL: Drilled Date Constructed

Depth drilled 142 Depth cased

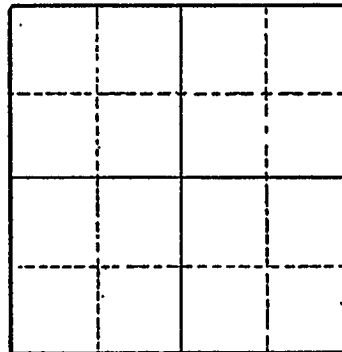

Section

CASING RECORD:

18 inch

FINISH:

AQUIFERS:

Lava breccia from 111 to 123.5

WATER LEVEL:

45.66 feet below land surface on September 4, 1952

PUMPING EQUIPMENT: Type H.P. Capacity G.P.M.

WELL TESTS:

Drawdown ft. after hours G.P.M.  
Drawdown ft. after hours G.P.M.

USE OF WATER Irrigation Temp. °F., 19

SOURCE OF INFORMATION USGS

DRILLER or DIGGER

ADDITIONAL DATA:

Log Water Level Measurements Chemical Analysis Aquifer Test

REMARKS:

Reportedly yields 4,200 gpm with less than 1 foot drawdown.

# KLAM 2263

STATE ENGINEER  
Salem, Oregon

State Well No. 37/10-990

County KLAMATH

Application No. U-453

## Water Level Record

OWNER: A. R. DEVINCENZE OWNER'S NO. 2

Description of measuring point: PRT ON W SIDE OF PUMP 1.0' ABOVE L.S.D.

AIRLINE SET AT 58'

Date	Water Level Feet (above) (below) Land Surface	Remarks	Date	Water Level Feet (above) (below) Land Surface	Remarks
9-26-61	48.0	TAPE HANGS AT 10' WSB			

REMARKS: \_\_\_\_\_  
\_\_\_\_\_  
\_\_\_\_\_