

STATE ENGINEER
Salem, Oregon

OBSERVATION WELL

KLAM
2379 Well Record

STATE WELL NO. 37/11½-36H(1)
COUNTY Klamath
APPLICATION NO. U-456


OWNER: Donald E. & Virginia H. Schreiner MAILING ADDRESS: Route 1, Box 150-A

LOCATION OF WELL: Owner's No. 1 CITY AND STATE: Bonanza, Oregon

SE ¼ NE ¼ Sec. 36 T. 37 N. S. R. 11½ W., W.M.

Bearing and distance from section or subdivision

corner N 3109' & W 168' from SE cor. Sec. 36

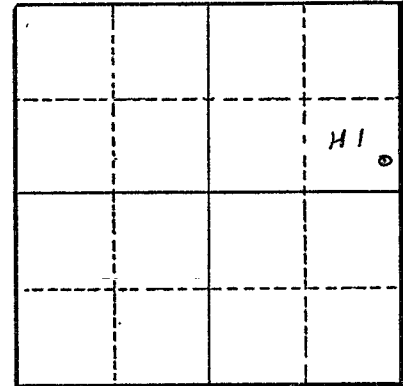

Altitude at well

TYPE OF WELL: Drilled Date Constructed 1953

Depth drilled 390 Depth cased

Section 36

CASING RECORD:

FINISH:

AQUIFERS:

Broken lava from 386 to 390'

WATER LEVEL:

154 feet below land surface August 1953

PUMPING EQUIPMENT: Type Turbine H.P. 100
Capacity 1800 G.P.M.

WELL TESTS:

Drawdown 16 ft. after 4 hours pumping 2000 G.P.M.

Drawdown ft. after hours G.P.M.

USE OF WATER Irrigation Temp. °F. 19

SOURCE OF INFORMATION U-456

DRILLER or DIGGER

ADDITIONAL DATA:

Log X Water Level Measurements Chemical Analysis Aquifer Test

REMARKS:

State Well No. 37/111-36H(1)
County Klamath
Application No. U-456

Owner: Donald E. & Virginia H. Schreiner Owner's No. 1

Driller: _____ Date Drilled: _____

[illegible]