

STATE ENGINEER
Salem, Oregon

KLAM
449

Well Record

STATE WELL NO. 24/11-35J
COUNTY Klamath
APPLICATION NO. U-148

OWNER: Gilchrist Timber Co. MAILING ADDRESS:

LOCATION OF WELL: Owner's No. CITY AND STATE: Gilchrist, Oregon

NE 1/4 SE 1/4 Sec. 35. T. 24 N. S., R. 11 E. W., W.M.


Bearing and distance from section or subdivision

corner

Altitude at well

TYPE OF WELL: Date Constructed June 1941

Depth drilled 745 Depth cased

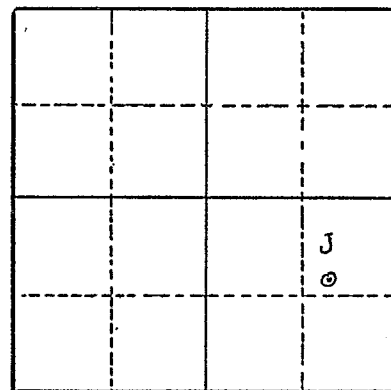

Section 35

CASING RECORD:

FINISH:

AQUIFERS:

WATER LEVEL:

460

PUMPING EQUIPMENT: Type H.P.
Capacity G.P.M.

WELL TESTS:

Drawdown ft. after hours G.P.M.

Drawdown ft. after hours G.P.M.

USE OF WATER Municipal Temp. °F., 19

SOURCE OF INFORMATION U-148

DRILLER or DIGGER A. M. Jannsen Drilling Co. Portland, Oregon

ADDITIONAL DATA:

Log Water Level Measurements Chemical Analysis Aquifer Test

REMARKS:

STATE ENGINEER
Salem, Oregon

State Well No. 24/11-35J
County Klamath
Application No. U-141

Well Log

Owner: Gilchrist Timber Co. Owner's No. _____

Driller: A. M. Jannsen Drilling Co. Date Drilled June 1941

CHARACTER OF MATERIAL	(Feet below land surface)		Thickness (feet)
	From	To	
Pumice stone	0	3	3
Rock	3	90	87
Red rock	90	125	35
Brown rock	125	144	19
Hard gray lava rock	144	205	61
Blue rock	205	228	23
Hard gray lava rock	228	248	20
Red and brown rock	248	260	12
Brown rock	260	275	15
Gray rock	275	310	35
Gray and brown rock	310	345	35
Brown rock	345	360	15
Gray rock	360	375	15
Gray and brown rock	375	400	25
Brown and black rock	400	430	30
Black rock	430	450	20
Black sand and red lava (hit some water at 460')	450	470	20
Black lava rock	470	482	12
Black and gray rock	482	510	28
Gray rock	510	535	25
Black rock	535	700	165
Black and brown rock	700	732	32
Brown and red rock	732	745	13