

KLAM 50362
OBSERVATION WELL
Well Record

STATE ENGINEER
Salem, Oregon

STATE WELL NO: 38/11 $\frac{1}{2}$ -6(1)
COUNTY Klamath
APPLICATION NO.

OWNER: L.M. Hankins (SWAN LAKE RANCH) MAILING ADDRESS:

LOCATION OF WELL: Owner's No. CITY AND STATE:


~~SW~~ ~~NW~~ 6 38 ~~S~~ 11 $\frac{1}{2}$ E
N.W. $\frac{1}{4}$ S.W. $\frac{1}{4}$ Sec. T. S., R. W.M.

Bearing and distance from section or subdivision corner

Altitude at well 4,188

TYPE OF WELL: Drilled Date Constructed

Depth drilled 224 Depth cased

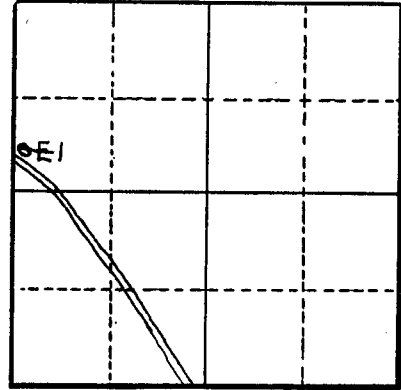

Section 6

CASING RECORD: 16 inches

FINISH:

AQUIFERS: Lava breccia from 174 to 224 ft.

WATER LEVEL: 89.65 feet below land surface, April 23, 1952.

PUMPING EQUIPMENT: Type Turbine H.P.
Capacity G.P.M.

WELL TESTS:
Drawdown ft. after hours G.P.M.
Drawdown ft. after hours G.P.M.

USE OF WATER Irrigation Temp. °F., 19....

SOURCE OF INFORMATION USGS

DRILLER or DIGGER

ADDITIONAL DATA:
Log Water Level Measurements Chemical Analysis Aquifer Test

REMARKS: Reported silt beds and talus blocks to 174 feet, water-bearing breccia layers in rock below; bailer samples from aquifer were water-rounded cobbles.

Well GE(1) in USGS Report

KLAM 50362

KLAM
50362

OBSERVATION WELL
Well Record

STATE ENGINEER
Salem, Oregon

STATE WELL NO. 38/11 1/2-6(1)
COUNTY Klamath
APPLICATION NO.

OWNER: L.M. Hankins (SWAN LAKE RANCH) MAILING ADDRESS:
CITY AND STATE:

LOCATION OF WELL: Owner's No.


SW NW 6 38 11 1/2 E.
N. 1/4 S. 1/4 Sec. T. S., R. W.M.

Bearing and distance from section or subdivision corner

Altitude at well 4,188

TYPE OF WELL: Drilled Date Constructed

Depth drilled 224 Depth cased

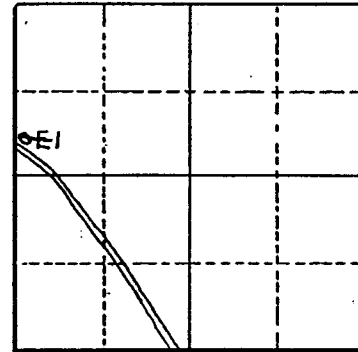

Section 6

CASING RECORD: 16 inches

FINISH:

AQUIFERS: Lava breccia from 174 to 224 ft.

WATER LEVEL: 89.65 feet below land surface, April 23, 1952.

PUMPING EQUIPMENT: Type Turbine Capacity G.P.M. H.P.

WELL TESTS: Drawdown ft. after hours G.P.M.
Drawdown ft. after hours G.P.M.

USE OF WATER Irrigation Temp. °F., 19.

SOURCE OF INFORMATION USGS
DRILLER or DIGGER

ADDITIONAL DATA: Log Water Level Measurements Chemical Analysis Aquifer Test

REMARKS: Reported silt beds and talus blocks to 174 feet. water-bearing breccia layers in rock below; bailer samples from aquifer were water-rounded cobbles.

Well 6E(1) in USGS Report.

