


License No. 51- Dated 6/18 1962

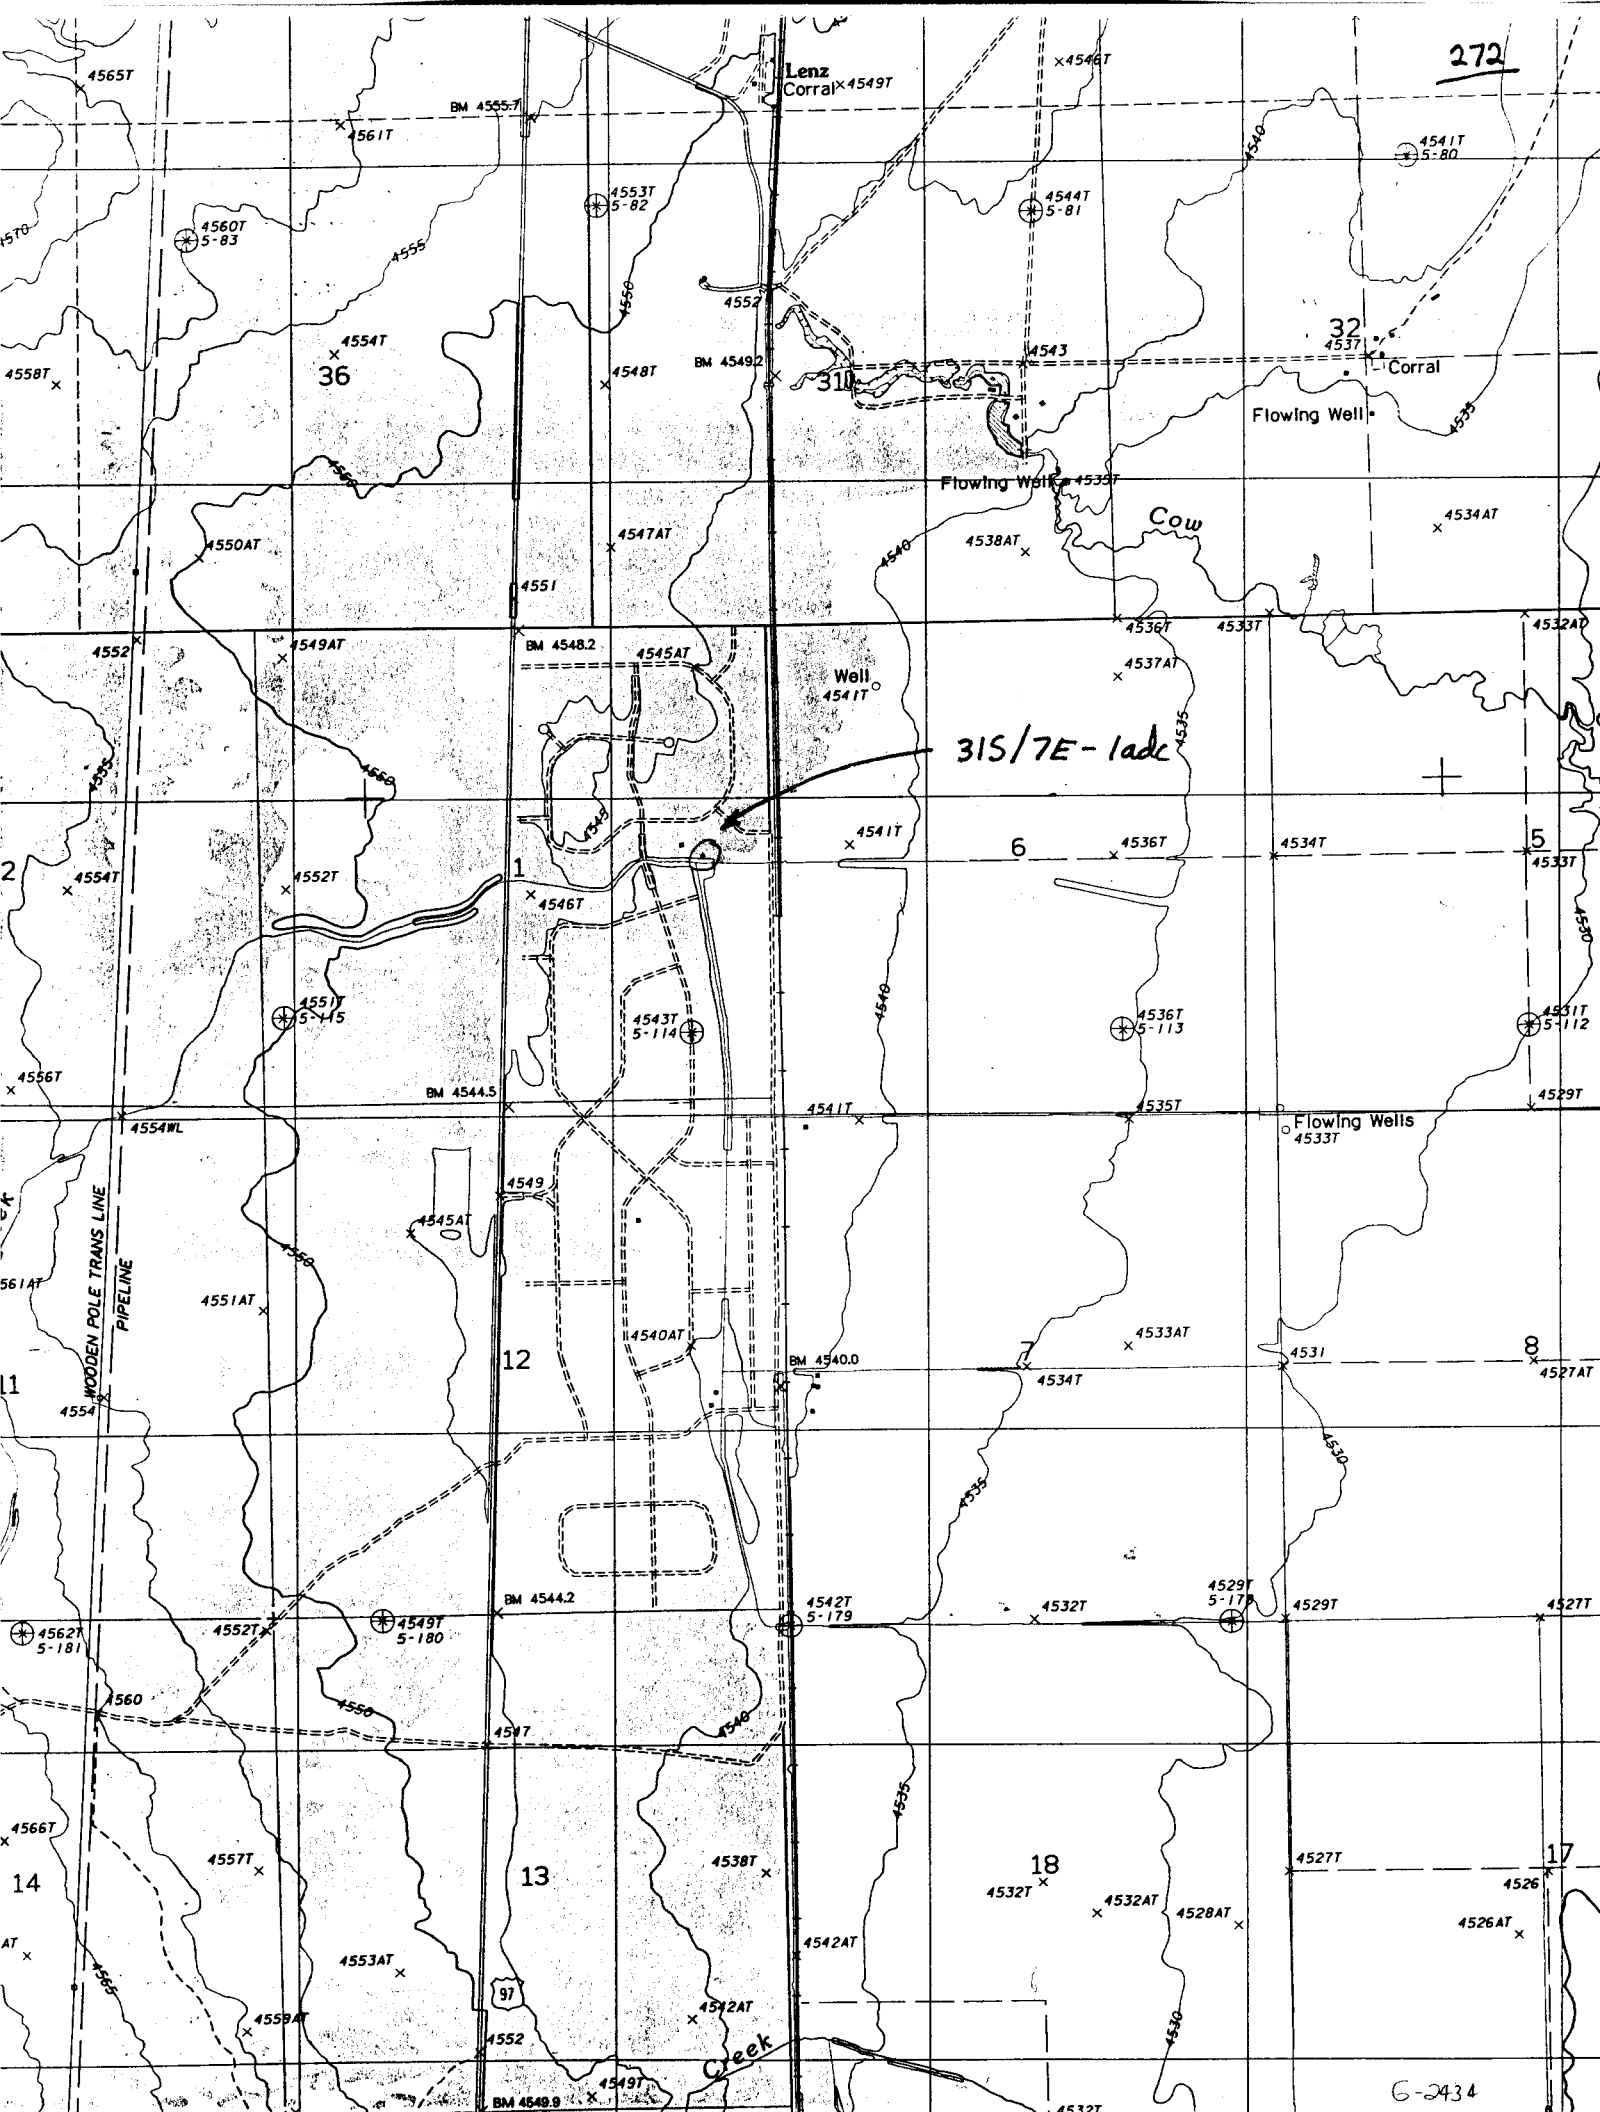

272

315/7E-1ade

G-2434



Oregon Water Resources Department
725 Summer Street NE, Suite A
Salem Oregon 97301
(503) 986-0900
www.oregon.gov/owrd

Application for Well ID Number

RECEIVED

OCT 24 2025

OWRD

Do not complete if the well already has a Well Identification Number.

I. OWNER INFORMATION *per county*

Current Owner Name (please print): Kim + Jan Manselle
Mailing Address: 4808 SE 11a Ave
City, State, Zip: Portland OR 97267
Mail Well ID to: ☐ SAME AS ABOVE ☒ In Care Of (C/O)
Name & Address: Dave Mosby Bar Y Ranch HC 63 Box 291
City, State, Zip: Chiloquin, OR 97624

II. WELL LOCATION INFORMATION (Please fill out as completely as possible)

Township: 31 S (North / South) Range: 7 E (East / West) Section: 1 NE 1/4 of the SE 1/4
Tax Lot (usually last 3-5 numbers of Tax Map #): 100 County Klamath
GPS Coordinates: 42.914613, -121.821629
Street Address of Well, City: no situs, east of Cloudcap Drive, Chiloquin, OR 97624
If the property had a different street address in the past: _____

III. GENERAL WELL INFORMATION (Please fill out as completely as possible, AND attach copy of Well Report, if available)

Use of Well (domestic, irrigation, commercial, industrial, monitoring): irrigation
Date Well Constructed (or property built): 6/15/1962 Total Well Depth: 322' Casing Diameter: 18"
Owner at time the well was constructed (if known): Yamsay Land & Cattle Well Report # (if known): KLAM 50590
Other Information: WR Cert 90001 Transfer T11922

SUBMITTED BY (please print): Scott D Montgomery assisting Mosby Family Trust
PHONE: 541-548-5833 EMAIL &/or FAX: scott@apeands.com

To send the completed application, you may MAIL it to: Oregon Water Resources Dept. 725 Summer St NE, Suite A, Salem, Oregon 97301.
Or EMAIL the completed PDF form to: Ladeena.K.Ashley@water.oregon.gov, or FAX it to: (503) 986-0902.

For Official Use Only by the Oregon Water Resources Department:

Received Date:

10-24-2025

Well Report Number:

KLAM 50590

Well Identification #:

L-159988

WRD staff
notes:

Last Update: 5-10-23

Well I.D. Number/2

WCC

Ownership of well + irrigation claimed to be retained by Mosby Family Trust via easement 2020-011186
equipment