RECEIVED

STATE OF OREGON
WATER WELL REPORT
(as required by ORS 537765)

NOV 23 1999
WATER RESOURCES DEPT.
SALEM, OREGON

Klam
52063

WELL ID # L37397
(START CARD)# 118145

99 22

(1) OWNER

GRIFFITH & PARKER
4582 FRESHWATER RD.
WILLIAMS CA 95987

(2) TYPE OF WORK : NEW WELL

(3) DRILL METHOD : ROTARY MUD

(4) PROPOSED USE: Irrigation

(5) BORE HOLE CONSTRUCTION:

Special Construction Approval NO Depth of Completed Well 1,500 ft.
Explosives used NO Type Amount

HOLE Diameter	From	To	SEAL Material	From	To	AMOUNT Sacks
17 1/2"	0	39	BENTONITE	0	39	49
12"	39	354				
10"	354	1500				

How was seal Placed POURED DRY
Backfil placed from ft. to ft. Material
Gravel placed from ft. to ft. Size of Gravel

(6) CASING / LINER:

	Dia.	From	To	Gage	Material
CASING	12"	+1	39	250	STEEL / WELDED

Final location of shoe (s)

(7) PERFORATIONS / SCREENS:

METHOD	TYPE	MATERIAL

From	To	Slot size	Number	Dia.	Tele / pipe size

(8) WELL TESTS: Minimum testing time is 1 hour

TESTING METHOD PUMP

Yield GPM	Drawdown	Drill stem at	Time
750	272'		4 HOUR

Temperature of Water 59 F° Depth Artesian Flow Found
Was a water analysis done? NO By whom
Did any strata contain water not suitable for intended use? No

(9) LOCATION OF WELL by legal description :

County KLAMATH Latitude Longitude
Township 35 S. Range 11 E.
Section 30 NE 1/4 SW 1/4
Tax Lot 1000 Lot Block Subdivision
Street Address of Well (or nearest address)
22779 SPRAGUE RIVER RD. SPRAGUE RIVER, OR

(10) STATIC WATER LEVEL:

48 ft. below land surface Date November 12, 1999
Artesian pressure Date

(11) WATER BEARING ZONES :

Depth at which water was first found 95'

From	To	Estimated Flow Rate	SWL
95'	178'	400 GPM	48'
656'	662'	200 GPM	48'
960'	1500'	400 GPM	48'

(12) WELL LOG:

Ground Elevation

	FROM	TO	SWL
SOIL	0	1	
GREY SANDSTONE	1	95	
GREY SANDSTONE & GREY CLAY	95	120	48'
BLACK SANDSTONE	120	178	48'
GREY SANDSTONE	178	656	
BLACK SANDSTONE	656	662	48'
GREY SANDSTONE & BLUE CLAY	662	960	
GREY SANDSTONE & WHITE PUMICE	960	1020	48'
GREY SANDSTONE & BLUE CLAY	1020	1170	48'
GREY & BROWN SANDSTONE	1170	1500	48'

Date started June 28, 1999 Completed November 12, 1999

(Unbonded) Water Well Constructor Certification: I certify that the work I performed on the construction, alteration, or abandonment of this well is in compliance with Oregon well construction standards. Materials used and information reported above are true to my best knowledge and belief.

DATE 11-19-99 WWC # 1452

(Bonded) Water Well Constructor Certification: I accept responsibility for the construction alteration or abandonment work performed on this well during the construction dates reported above. All work performed during this time is in compliance with Oregon well construction standards. This report is true to the best of my knowledge and belief.


DATE 11-19-99 WWC # 693

THIS MAP WAS PREPARED FOR ASSESSMENT PURPOSE ONLY.

KLAMATH COUNTY

1"=400'


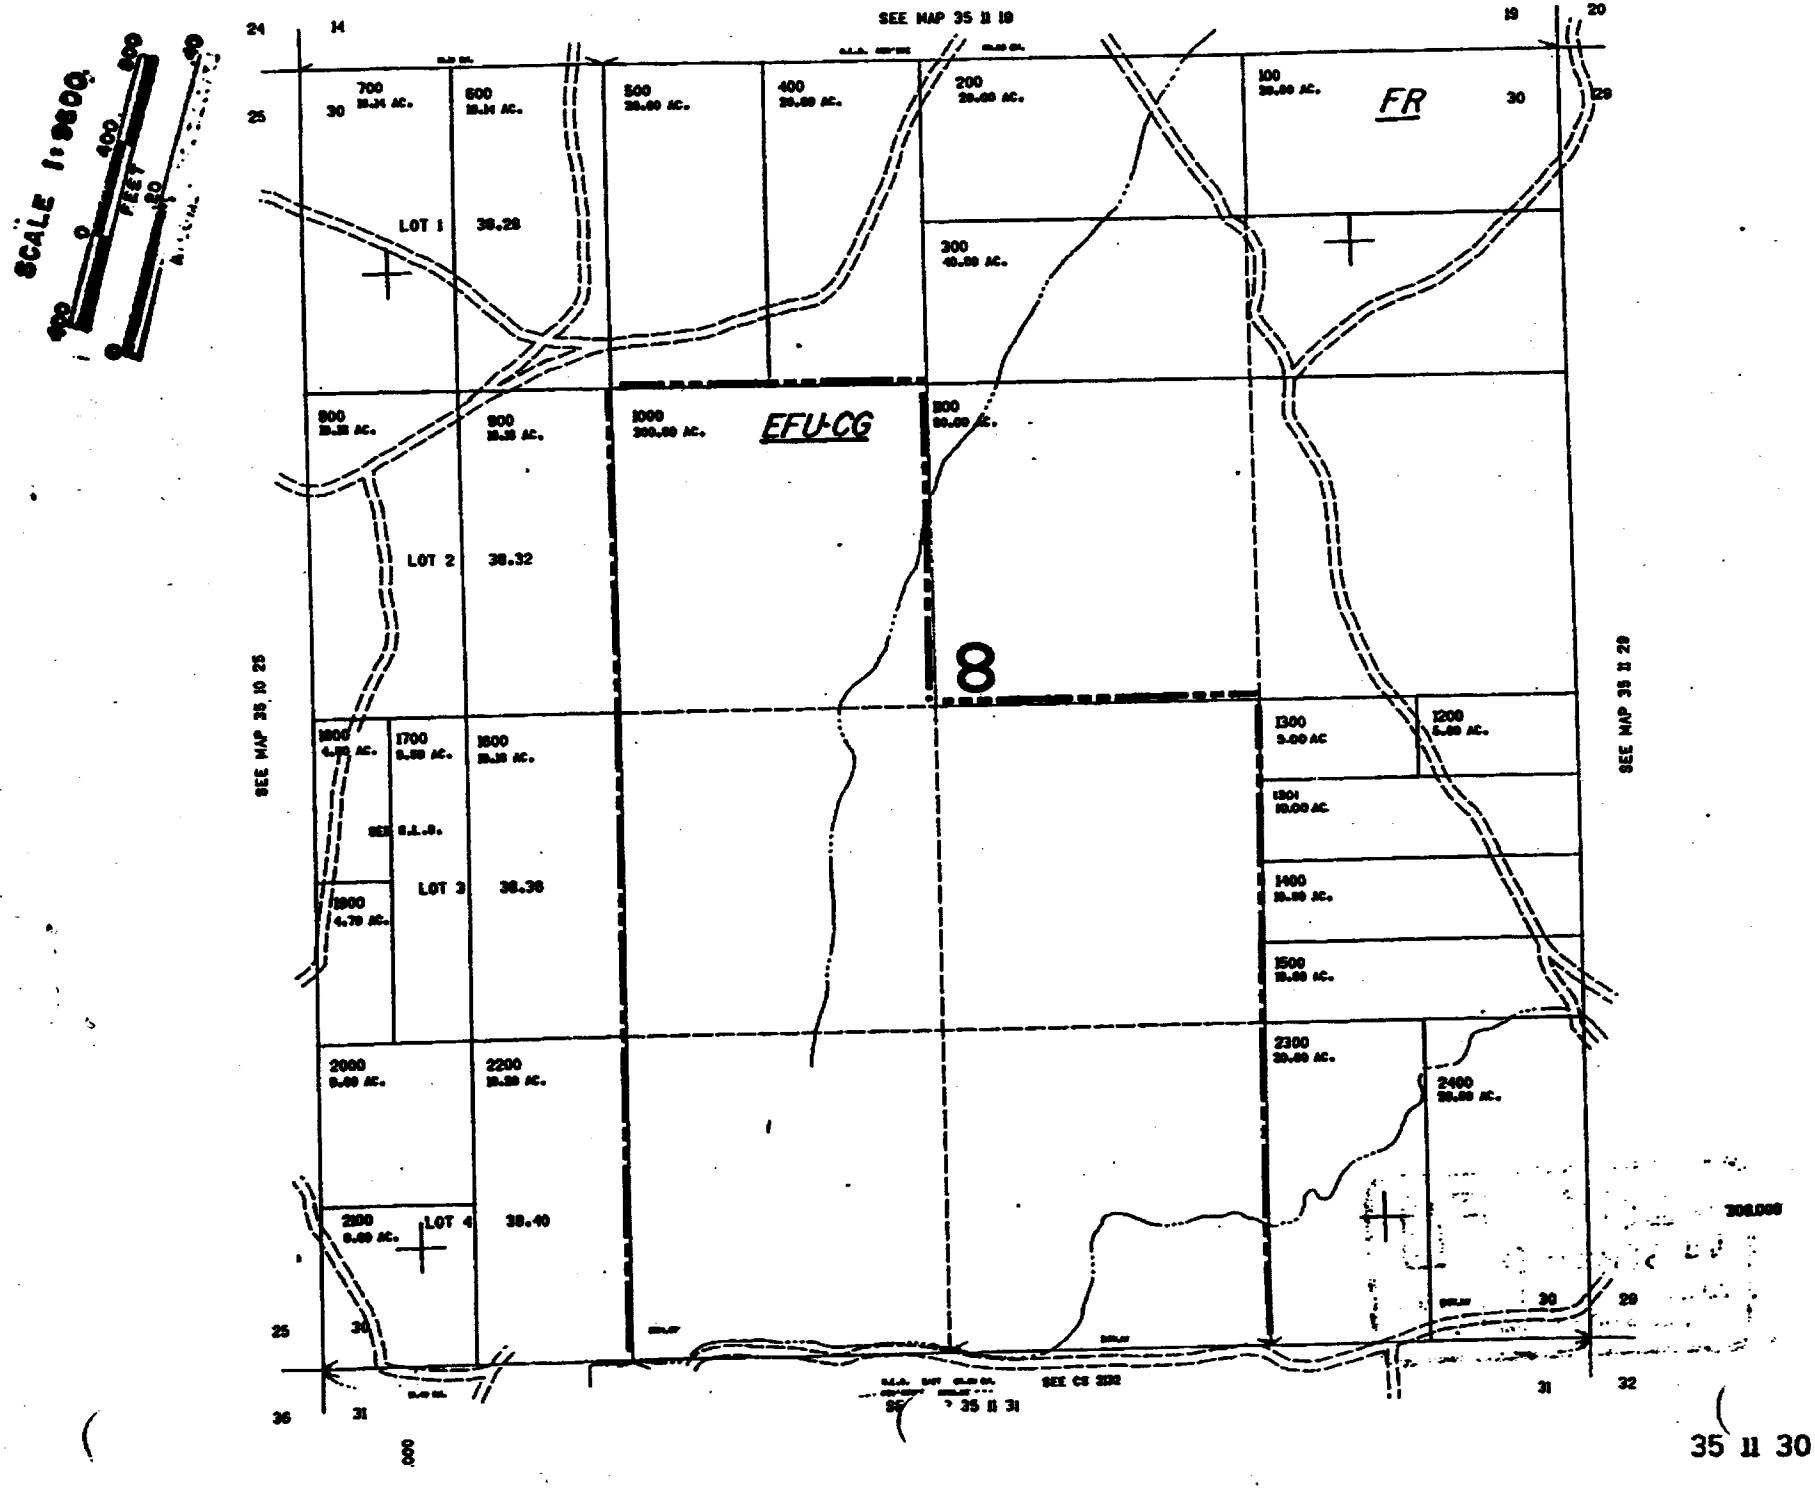

35 11 30