

STATE OF OREGON
WATER WELL REPORT
(as required by ORS 537.700)

KLAM 54853 WELL ID # 175126

(START CARD) # 175126

(1) OWNER
BRADY SWEAT
27770 HWY 70
BONANZA

RECEIVED
MAY 19 2005
MAY 19 2005

WATER RESOURCES DEPT
SALEM, OREGON OR 97623

(2) TYPE OF WORK : NEW WELL

(3) DRILL METHOD : ROTARY AIR

(4) PROPOSED USE: STOCK WATER

(5) BORE HOLE CONSTRUCTION:

Special Construction Approval NO Depth of Completed Well 222 ft.
Explosives used NO Type NO Amount NO
HOLE SEAL AMOUNT
Diameter From To Material From To Sacks
10" 0 19 BENTONITE 0 19 9
6" 19 222

How was seal Placed POURED DRY
Backfill placed from 0 ft. to 19 ft. Material BENTONITE
Gravel placed from 19 ft. to 222 ft. Size of Gravel 222

(6) CASING / LINER:

	Dia.	From	To	Gage	Material
CASING	6"	+1	19	250	STEEL
LINER	4 1/2	4	222	160	CERTA-LOC

Final location of shoe (s) 222

(7) PERFORATIONS / SCREENS:

Perforations
METHOD TYPE MATERIAL
SAW PVC
From To Slot size Number Dia. Tele / pipe size
182 222 1/8 X 5 80 4 1/2

(8) WELL TESTS:

Minimum testing time is 1 hour
TESTING METHOD AIR
Yield GPM Drawdown Drill stem at Time
100 220' 1 HOUR
30 120' 1 HOUR
Temperature of Water 58 F Depth Artesian Flow Found 222
Was a water analysis done? NO By whom NO
Did any strata contain water not suitable for intended use? NO

(9) LOCATION OF WELL by legal description :

County KLAMATH Latitude 42° 15' N Longitude 121° 15' W
Township 39 S Range 11 E
Section 6 NW 1/4 SE 1/4
Tax Lot 700 Lot 700 Block 700 Subdivision 700
Street Address of Well (or nearest address)
27770 HWY 70 BONANZA, OR

(10) STATIC WATER LEVEL:

76 ft. below land surface Date May 17, 2005
Artesian pressure 76' Date May 17, 2005

(11) WATER BEARING ZONES :

Depth at which water was first found 104
From To Estimated Flow Rate SWL
104 222 100 GPM 76'

(12) WELL LOG:

	Ground Elevation		SWL
	FROM	TO	
SOIL	0	1	
BROWN SAND & BOULDERS	1	7	
BROWN CLAYSTONE	7	11	
GREY BASALT	11	33	
BROWN WEATHERED BASALT	33	39	
RED CLAY & ROCK	39	42	
BROWN SANDSTONE	42	48	
GREY BASALT BROKEN	48	54	
BROWN CLAY & ROCK	54	61	
BROKEN GREY BASALT	61	104	
BLACK SANDSTONE	104	196	76'
WEATHERED BASALT	196	222	

Date started May 16, 2005

Completed May 17, 2005


(Unbonded) Water Well Constructor Certification: I certify that the work I performed on the construction, alteration, or abandonment of this well is in compliance with Oregon well construction standards. Materials used and information reported above are true to my best knowledge and belief.

Don Duane DATE 5-16-05 WWC # 1758


(Bonded) Water Well Constructor Certification: I accept responsibility for the construction alteration or abandonment work performed on this well during the construction dates reported above. All work performed during this time is in compliance with Oregon well construction standards. This report is true to the best of my knowledge and belief.

Don Duane DATE 5-18-05 WWC # 693

SEE MAP 39 II 05

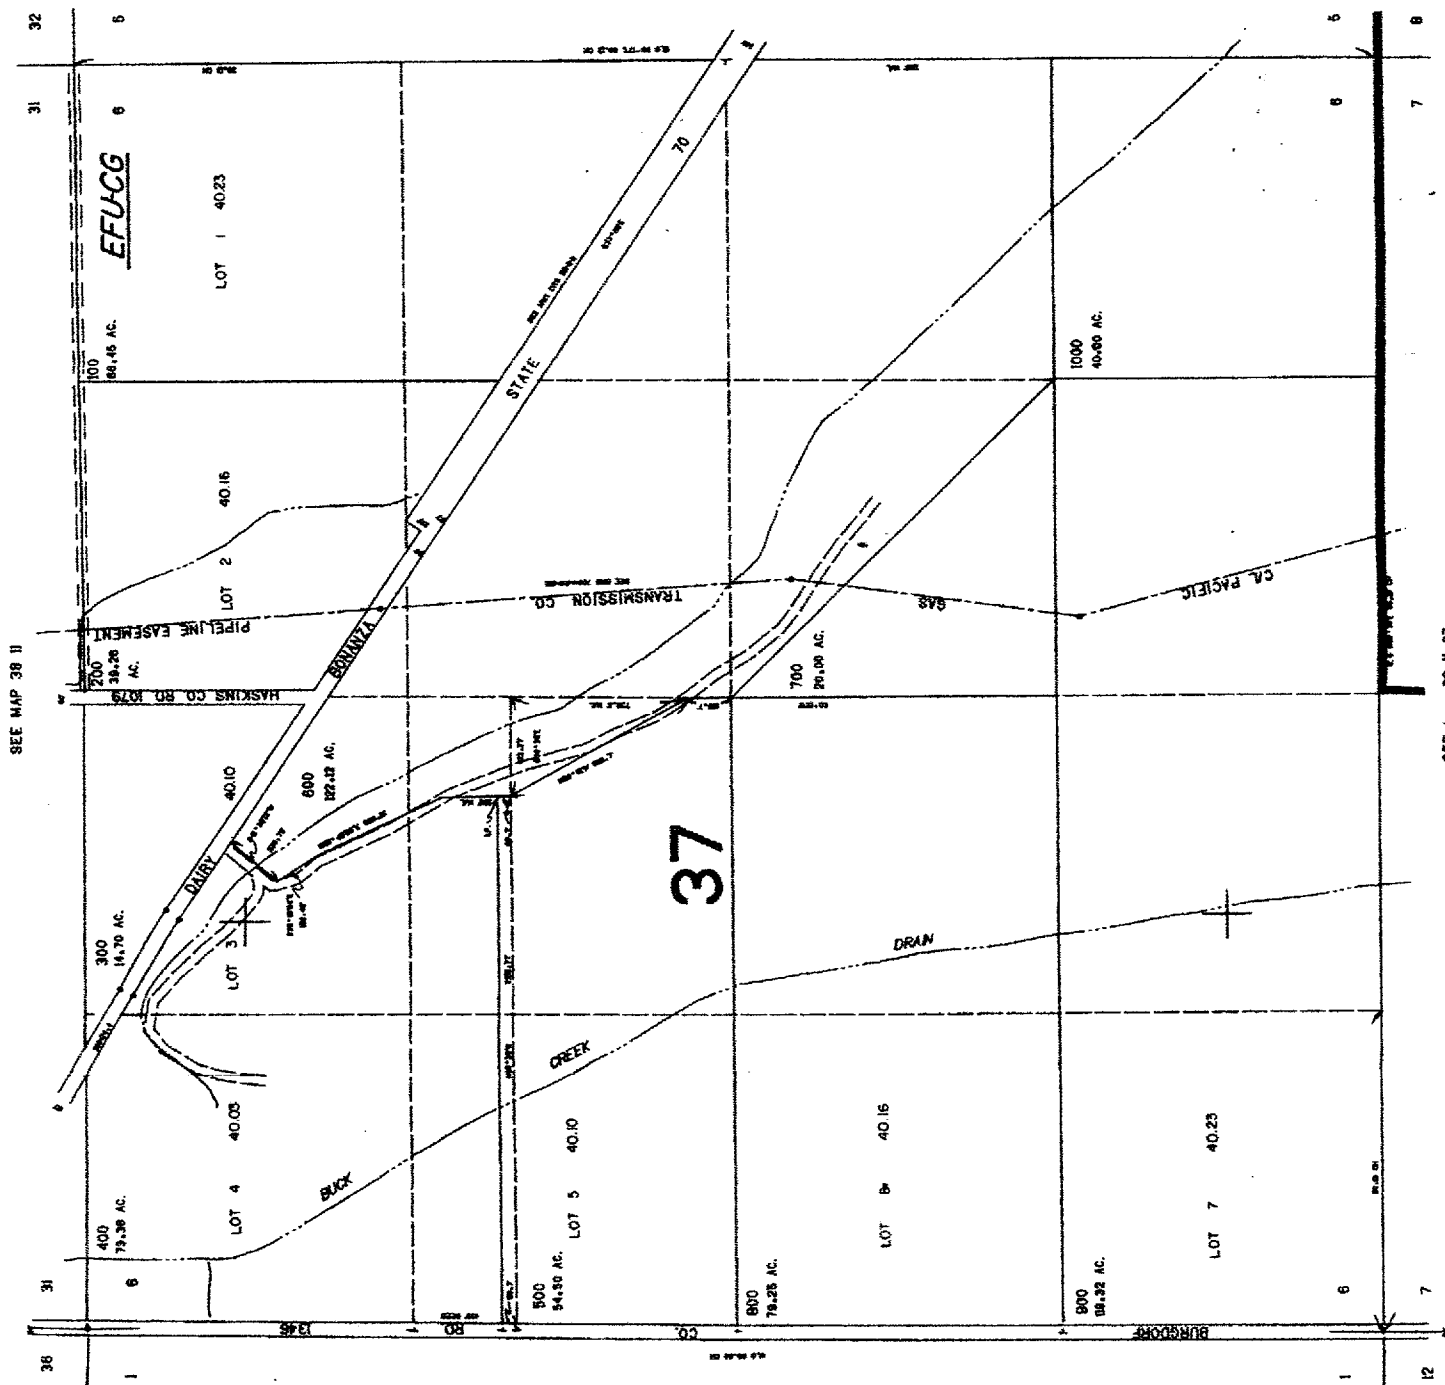

SEE MAP 39 IIV

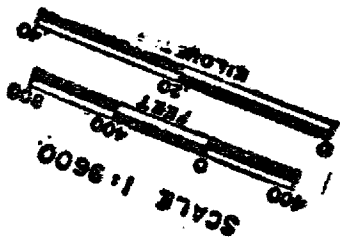

SEE MAP 39 II 07