

STATE OF OREGON

WATER SUPPLY WELL REPORT

(as required by ORS 537.765 & OAR 690-205-0210)

12-04-2009

WELL LABEL # L 100677

START CARD # 1008879

(1) LAND OWNER Owner Well I.D. First Name J. MICHAEL & SHARON Last Name BAILEY Company Address 217 VINE ST. City MURRY State UT Zip 84107

(2) TYPE OF WORK [X] New Well [] Deepening [] Conversion [] Alteration (repair/recondition) [] Abandonment

(3) DRILL METHOD [X] Rotary Air [] Rotary Mud [] Cable [] Auger [] Cable Mud [] Reverse Rotary [] Other

(4) PROPOSED USE [X] Domestic [] Irrigation [] Community [] Industrial/ Commercial [] Livestock [] Dewatering [] Thermal [] Injection [] Other

(5) BORE HOLE CONSTRUCTION Special Standard [] (Attach copy) Depth of Completed Well 461.00 ft.

Table with columns: Dia, From, To, Material, SEAL, Amt, lbs. Rows include Bentonite Chips and Cement.

How was seal placed: Method [] A [] B [X] C [] D [] E [X] Other Bent. poured dry Backfill placed from 0 ft. to 168 ft. Material Cement Filter pack from 0 ft. to 168 ft. Material Cement Size 171 Explosives used: [] Yes Type Amount

(6) CASING/LINER Casing Liner Dia + From To Gauge Stl Plstc Wld Thrd Shoe [] Inside [X] Outside [] Other Location of shoe(s) 171 Temp casing [] Yes Dia From To

(7) PERFORATIONS/SCREENS Perforations Method Screens Type Material Perf/S Casing/ Screen green Liner Dia From To Scrn/slot width Slot length # of slots Tele/ pipe size

(8) WELL TESTS: Minimum testing time is 1 hour [] Pump [] Bailer [X] Air [] Flowing Artesian Yield gal/min Drawdown Drill stem/Pump depth Duration (hr)

Temperature 61 °F Lab analysis [] Yes By Water quality concerns? [] Yes (describe below) From To Description Amount Units

(9) LOCATION OF WELL (legal description) County Klamath Twp 39.00 S N/S Range 10.00 E E/W WM Sec 9 NE 1/4 of the NW 1/4 Tax Lot 901 Tax Map Number Lot Lat Long Street address of well Nearest address NEXT TO 3114 PINE GROVE RD. KLAMATH FALLS, OR 97603

(10) STATIC WATER LEVEL Date SWL(psi) + SWL(ft) Existing Well / Predeepening Completed Well 12-02-2009 152 Flowing Artesian? [] Dry Hole? []

WATER BEARING ZONES Depth water was first found 125 SWL Date From To Est Flow SWL(psi) + SWL(ft)


(11) WELL LOG Ground Elevation 4,150 Material From To Top Soil 0 2 Brown Sand & Sandstone 2 15 Brown Clay 15 39 Gray Clay 39 125 Gray Clay with Streaks of Black Sand & Sandstone 125 162 Gray Clay 162 326 Gray Clay with Streaks of Black Sand & Sandstone 326 402 Gray Clay 402 461

Date Started 11-30-2009 Completed 12-02-2009

(unbonded) Water Well Constructor Certification I certify that the work I performed on the construction, deepening, alteration, or abandonment of this well is in compliance with Oregon water supply well construction standards. License Number 1560 Date 12-04-2009 Electronically Filed Signed JAMES B PINKARD (E-filed)

(bonded) Water Well Constructor Certification I accept responsibility for the construction, deepening, alteration, or abandonment work performed on this well during the construction dates reported above. License Number 777 Date 12-04-2009 Electronically Filed Signed STEPHEN R HUGHES (E-filed) Contact Info (optional)

EXEMPT USE WELL LOCATION MAP

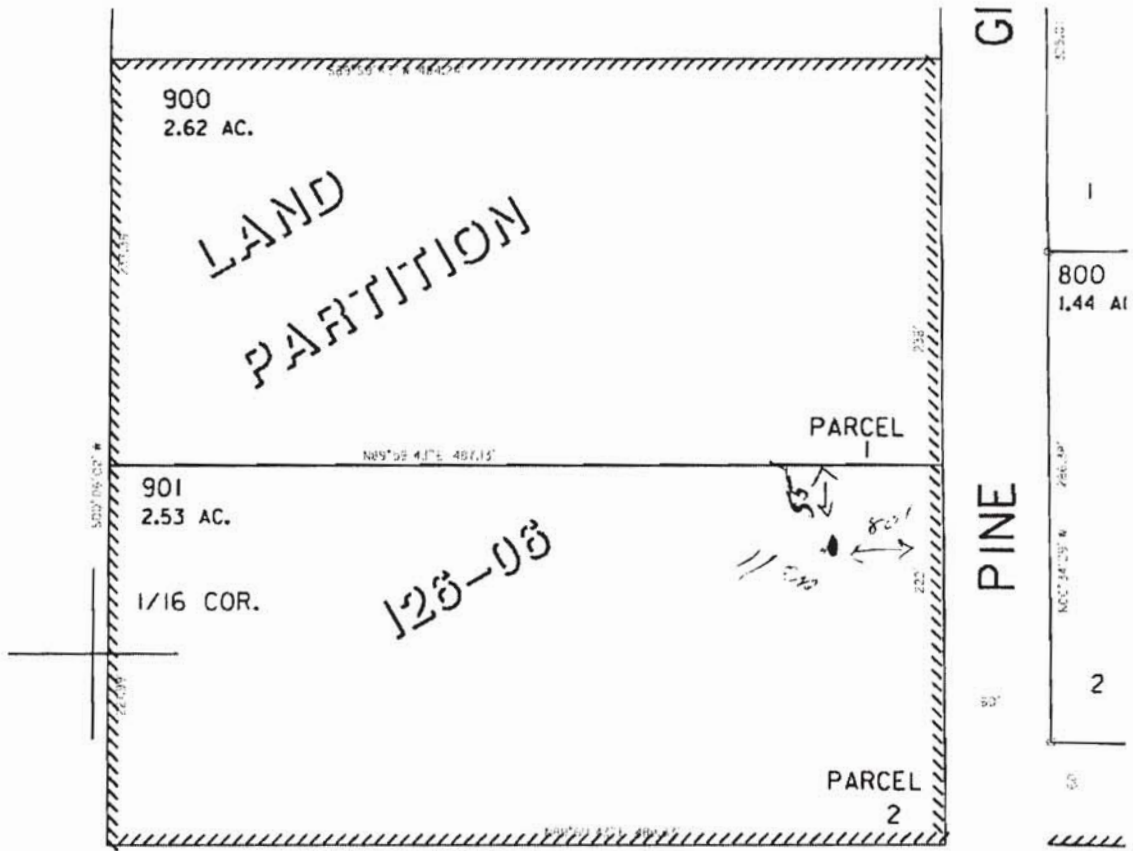

SEE MAP 39 10 00.



RECEIVED

DEC 28 2009

WATER RESOURCES DEPT
SALEM, OREGON

Klamath County

Assessor Map Reference Number: 39S 10E 9 NENW; Tax Lot 901

Street Address of Well, if Available: **Next to 3114 Pine Grove Road, Klamath Falls, OR**

Well Log # **KLAM 57230**, Well Label (ID) # **L 100677**. (Please Locate Well and Indicate distance From Property or Survey Corner and add Well Label, See Attached Sample Well Location Map.) **MAP NOT TO SCALE**

*no structure exist at this time
not to scale*

LAND OWNER SUBMITTED MAP