

WELL I.D. # L

(1) LAND OWNER Well Number _____
 Name Jim Emard
 Address 40770 Hwy 62
 City Chiloquin State OR Zip 97624

(2) TYPE OF WORK
 New Well Deepening Alteration (repair/recondition) Abandonment

(3) DRILL METHOD:
 Rotary Air Rotary Mud Cable Auger
 Other Drilled

(4) PROPOSED USE:
 Domestic Community Industrial Irrigation
 Thermal Injection Livestock Other

(5) BORE HOLE CONSTRUCTION:
 Special Construction approval Yes No Depth of Completed Well 300+ ft.
 Explosives used Yes No Type _____ Amount _____

HOLE		SEAL		Material	From	To	Sacks or pounds
Diameter	From	To					
12							

How was seal placed: Method A B C D E
 Other _____

Backfill placed from _____ ft. to _____ ft. Material _____
 Gravel placed from _____ ft. to _____ ft. Size of gravel _____

(6) CASING/LINER:

Diameter	From	To	Gauge	Steel	Plastic	Welded	Threaded
Casing: 12				<input type="checkbox"/>	<input type="checkbox"/>	<input type="checkbox"/>	<input type="checkbox"/>
Liner:				<input type="checkbox"/>	<input type="checkbox"/>	<input type="checkbox"/>	<input type="checkbox"/>

Drive Shoe used Inside Outside None
 Final location of shoe(s) _____

(7) PERFORATIONS/SCREENS:

From	To	Slot size	Number	Diameter	Tele/pipe size	Casing	Liner
						<input type="checkbox"/>	<input type="checkbox"/>

(8) WELL TESTS: Minimum testing time is 1 hour

Yield gal/min	Drawdown	Drill stem at	Flowing Artesian	Time 1 hr.
			<input type="checkbox"/>	

Temperature of water 58 Depth Artesian Flow Found _____
 Was a water analysis done? Yes By whom _____
 Did any strata contain water not suitable for intended use? Too little
 Salty Muddy Odor Colored Other _____
 Depth of strata: _____

(9) LOCATION OF WELL by legal description:
 County Klamath Latitude _____ Longitude _____
 Township 34 S N or S Range 7 E E or W. WM.
 Section 30 NE 1/4 SW 1/4
 Tax Lot 801 Lot _____ Block _____ Subdivision _____
 Street Address of Well (or nearest address) _____

(10) STATIC WATER LEVEL: Artesian on 5 May 1980
 _____ ft. below land surface. Date _____
 Artesian pressure 2 lb. per square inch Date _____

(11) WATER BEARING ZONES:

Depth at which water was first found _____

From	To	Estimated Flow Rate	SWL
Not found			

(12) WELL LOG:

Ground Elevation _____

Material	From	To	SWL
Not found			

Date started _____ Completed _____
No Well Construction dates

SOURCE OF DATA/INFO
Final proof survey in file G-15089

COMPILED BY: GERALD H. GRONDIEN

DATE: 2 July 2013

Interstate PUMP COMPANY, INC.

503-882-3464 — 7209 SOUTH SIXTH STREET
 KLAMATH FALLS, OREGON 97601

WELL TEST REPORT

For: Charles Kimbol

P.O. Box 226

Date Tested May 5, 1980

Chiloquin, Oregon 97624

Location of Well

Inside Diameter 12" Depth 300+

Feet of Inch Casing. Driller

150' Feet of 8 Inch Column and 5 Stage 10 Inch Bowls

Test Done By Darrell Campbell, Mac McCowan, Lee Campbell

Static Water Level at Start of Test artesian

CAPACITY GPM	PUMPING LEVEL	DRAWDOWN	TIME	CONDITION OF WATER (SANDY MUDDY CLEAR, ETC)
1475	86'		9:45	Clear. Started test.
1600	105'		10:00	"
1625	108'		10:15	"
1795	122'		10:20	"
1900	137'		10:25	"
1900	137'		10:30	"
1900	137'		11:00	"
1875	140'		11:30	Clear.
1850	145'		12:00	"
1825	147'		12:30	"
1575	133'		12:50	"
1470	123'		1:20	"
1420	118'		1:30	"
1300	111'		1:45	Clear. Shut test off.

Total Pumping 4 hrs.

TEMPERATURE 58° F.

Static Water Level After Pump Removed

REMARKS:

RECEIVED

MAR 07 2011

WATER RESOURCES DEPT
 SALEM, OREGON

Signed by *Lee Campbell*

FINAL PROOF MAP

FOR
JIM EMARD

LOCATED IN SEC. 30, T.34S., R.07E., W.M.
KLAMATH COUNTY, OREGON

APPLICATION No.: G-15089
PERMIT No.: G-15342



SCALE: 1" = 1320'

1320 0 660 1320 2460





1 inch = 1320ft.

Tax Lot Number 3407-03000-00801

NOTES:

1. THIS MAP WAS PREPARED FROM FIELD MEASUREMENTS, NAIP 2005 AERIAL PHOTOGRAPHY, KLAMATH COUNTY ASSESSORS MAP AND OREGON GLO MAPS.

2. THE PURPOSE OF THIS MAP IS TO IDENTIFY THE LOCATION OF THE WATER RIGHT ONLY, AND IS NOT INTENDED TO PROVIDE DIMENSIONS OR LOCATION OF PROPERTY LINES.

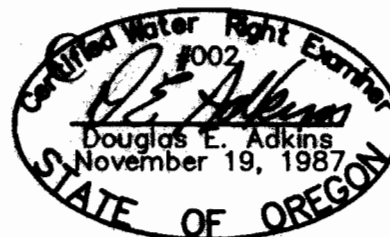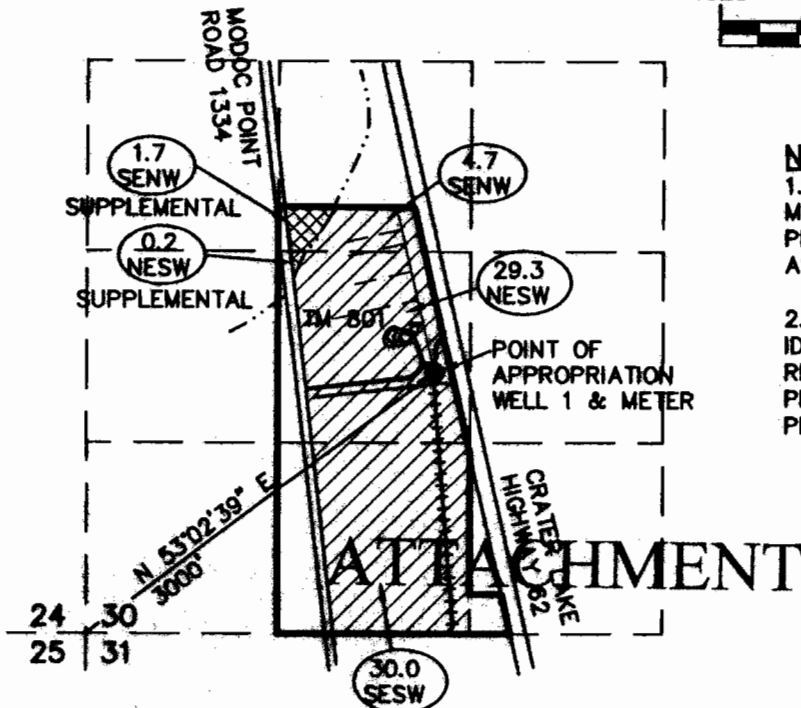

EXPIRES 1/1/13

James E. Emard
Applicant Signature

GOV'T LOT	1/4 1/4	SECTION	TOWNSHIP	RANGE	TAX LOT #	# IRRIGATED ACRES	ALLOWED ACREAGE
	SESW	30	T34S	07E	801	6.4	10.0
	NESW	30	T34S	07E	801	29.5	35.0
	SESW	30	T34S	07E	801	30.0	35.0

TOTAL IRRIGATED ACRES: 65.9 80.0

LEGEND



IRRIGATED ACREAGE



SUPPLEMENTAL ACREAGE

29.25
NESW

IRRIGATED ACRES

1/4 1/4 SECTION

TM 801 TAX MAP NUMBER

PROPERTY BOUNDARY LINE

● WELL & METER

--- 1/4 1/4 SECTION LINE

==== ROADS

++++ 4" WHEEL LINE

==== 8" MAINLINE

==== 4" MAINLINE

--- 3" HANDLINES

□ EXISTING STRUCTURE

--- EXISTING DITCH

ADKINS

CONSULTING
ENGINEERS, INC.

2950 Shasta Way · Klamath Falls, Oregon 97603 · (541) 884-4886
February 28, 2011

RECEIVED

MAR 07 2011

WATER RESOURCES DEPT
RECEIVED
OREGON

Engineers ▲ Planners ▲ Surveyors

WATER RESOURCES DEPT
SALEM, OREGON