

STATE ENGINEER
Salem, Oregon

KLAM
589


OBSERVATION WELL
Well Record

STATE WELL NO. 30/7-116(1)
COUNTY Klamath
APPLICATION NO.

OWNER: Klamath Indian Reservation
(Crown Zellerbach)

MAILING ADDRESS:
CITY AND STATE:

LOCATION OF WELL: Owner's No.
SW 1/4 NE 1/4 Sec. 11 T. 30 S., R. 7 E. W.M.

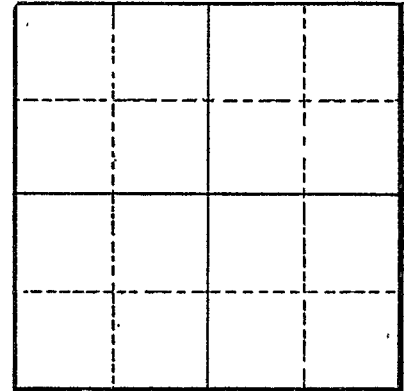

Bearing and distance from section or subdivision corner

Altitude at well 4625

TYPE OF WELL: Dr. Date Constructed

Depth drilled 122.8 Depth cased

Section 11

CASING RECORD:
6-inch

FINISH:

AQUIFERS:

WATER LEVEL:
56.74 (8-27-54)

PUMPING EQUIPMENT: Type plunger H.P.
Capacity G.P.M.

WELL TESTS:
Drawdown ft. after hours G.P.M.
Drawdown ft. after hours G.P.M.

USE OF WATER stock & observation Temp. °F., 19
SOURCE OF INFORMATION USGS

DRILLER or DIGGER
ADDITIONAL DATA:

Log Water Level Measurements X Chemical Analysis Aquifer Test

REMARKS:

STATE ENGINEER
Salem, Oregon

State Well No. 30/7-116(1)

County KLAMATH

Application No. _____

Water Level Record

OWNER: KLAMATH INDIAN RES. OWNER'S NO. _____

Description of measuring point: TOP OF CASING, 0.4' ABOVE L.S.D.

Date	Water Level Feet (above) (below) Land Surface	Remarks	Date	Water Level Feet (above) (below) Land Surface	Remarks
8-27-54	56.74				
9-29-54	57.39		5-3-61	63.44	
10-15-54	57.45		9-15-61	64.34	
10-26-54	58.29		1-10-62	IMPASSIBLE ROAD	
11-23-54	58.31				
12-18-54	58.41				
6-27-55	57.40				
8-26-55	58.08				
10-11-56	57.60				
12-22-56	57.56				

REMARKS: _____

UNITED STATES
DEPARTMENT OF THE INTERIOR
GEOLOGICAL SURVEY

30/7-11 G(1)
Klamath

WATER RESOURCES DIVISION

Report Page No. _____
GROUND WATER BRANCH

COUNTY Klamath

STATE Oregon

WATER LEVELS AND ARTESIAN PRESSURES IN OBSERVATION WELLS

30/7-11G1. Unknown, formerly Bureau of Indian Affairs. Drilled stock water-table well, diameter 6 inches, depth 122.8 feet. Land-surface datum is 4,626 feet above msl. MP is top of casing, 0.4 feet above lsd.

Highest water level 55.92 below lsd Dec. 3 1958; lowest 64.34 below lsd Sept. 15 1961

Records available 1954-

Water level Feet below lsd

Date	Water level	Date	Water level	Date	Water level	Date	Water level
1954	—	1959	—				
AUG 27	56.74	JUNE 11	56.96				
SEPT 29	57.39	SEPT 2	57.72				
OCT 15	57.45	1960	—				
OCT 26	56.29	JUNE 12	60.47				
NOV 23	56.31	OCT 13	61.80				
DEC 18	56.41	1961	—				
1955	—	MAY 3	63.44				
JUNE 27	57.40	SEPT 15	64.34				
AUG 26	58.08	1962					
1956	—	4-2	65.62				
OCT 11	57.60						
DEC 22	57.56						
1957	—						
APR 20	57.10						
JULY 25	56.94						
1958	—						
AUG 7	56.17						
DEC 3	55.92						